




DATE 11-5-82

TOWN OF LEXINGTON — BOARD OF PUBLIC WORKS

SEWER DIVISION

Sketch of Service Here 82

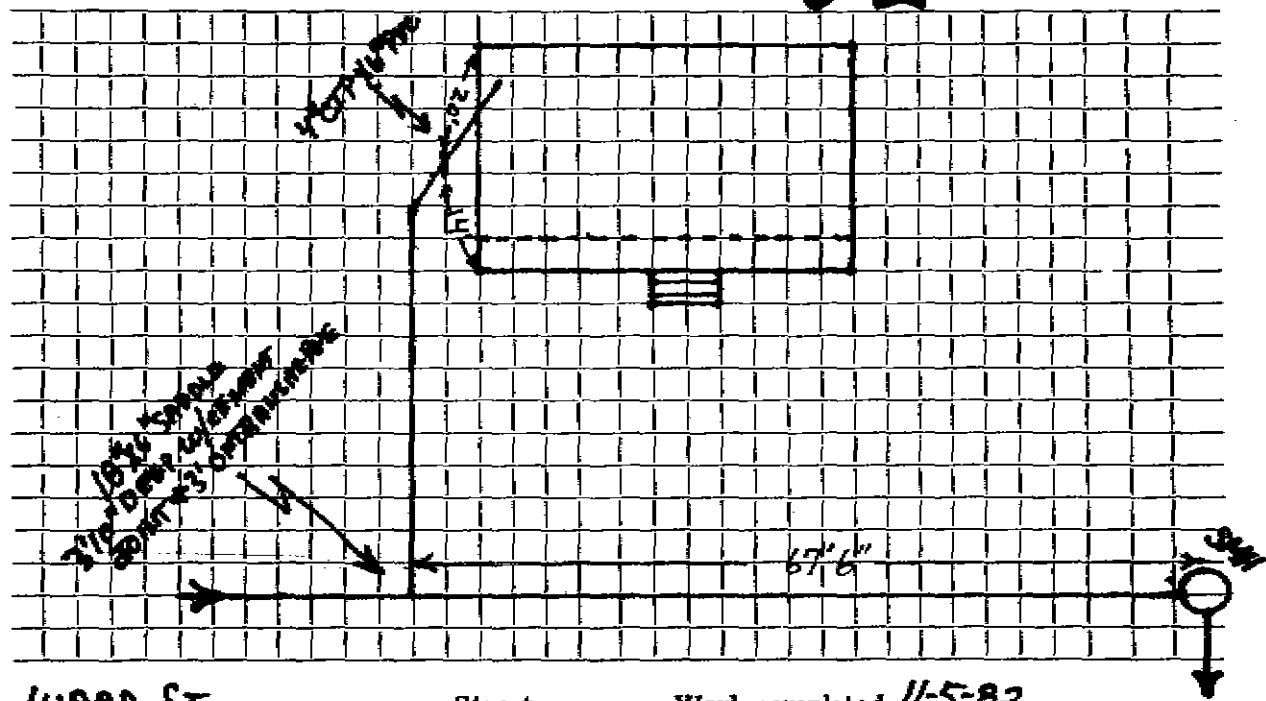

Connection made in WARD ST. Street. Work completed 11-5-82

Remarks: ONE AUTOMATIC AND ONE MANUAL CHECK VALVE INSTALLED IN HOUSE.

TOP OF SEWER MAIN ONLY. 6" DEBRIS TRAP INST. AT HOUSE.