




DATE 9-13-'90

TOWN OF LEXINGTON — BOARD OF PUBLIC WORKS

SEWER DIVISION

Sketch of Service Here **6**

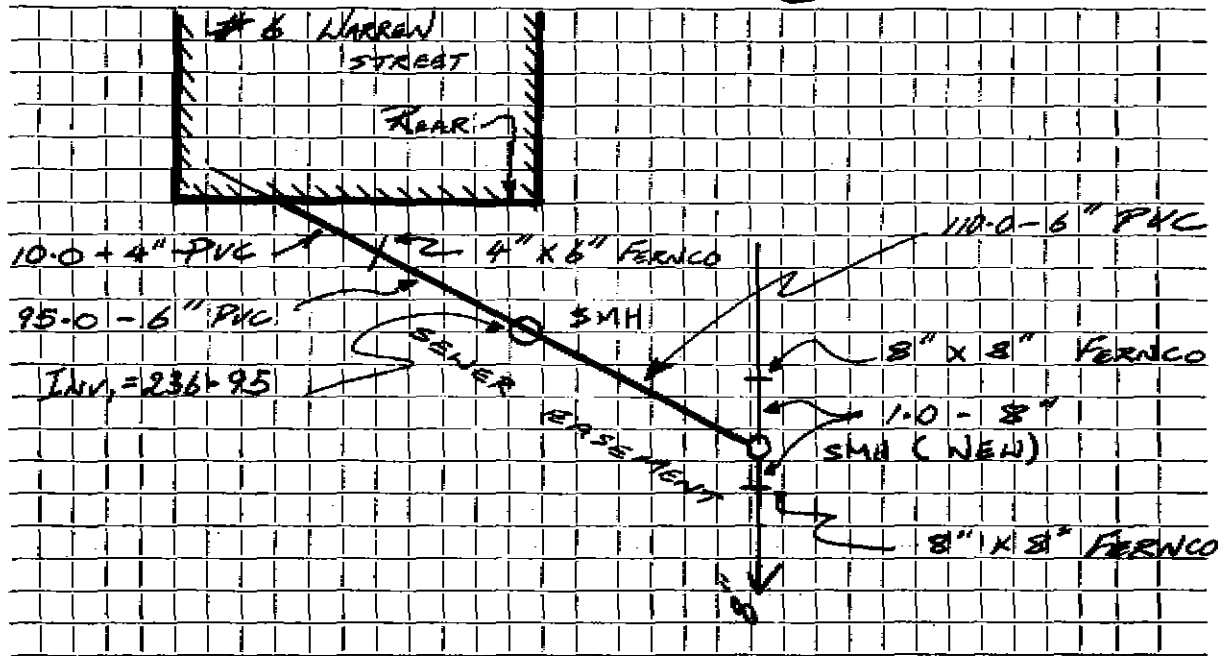

Connection made in WARREN Street. Work completed .....

Remarks: .....