

Name CHARLES F. Clerk  
 Address 9 WATSON STREET

Service No. 107

9 WATSON STREET

Location

Kind of Pipe

Size 6"

Size of Main 8"

~~XXXXXXXXXX~~ New Service

Location Cross 8-1-60

Date	Material	Amount	Total	Date	Amount
1-27-60	Labor	195 20		1-27-60	400 00
52'	10% O.H.	19 52	214 72	1-27-60	9 82
3	6" Transite pipe @78		40 56		308 18
3	Hrs Town Shovel @6.50		19 50		
3	Hrs Trucking @3.00		9 00		
1	Manhole Cover & Frame		10 50		
200	Cement Brick @4.20/100		8 40		
3	Bags Cement @1.50		4 50		
1	Ton Sand @1.00		1 00		
			308 18		


DATE \_\_\_\_\_

TOWN OF LEXINGTON — BOARD OF PUBLIC WORKS

SEWER DIVISION

Sketch of Service Here

9

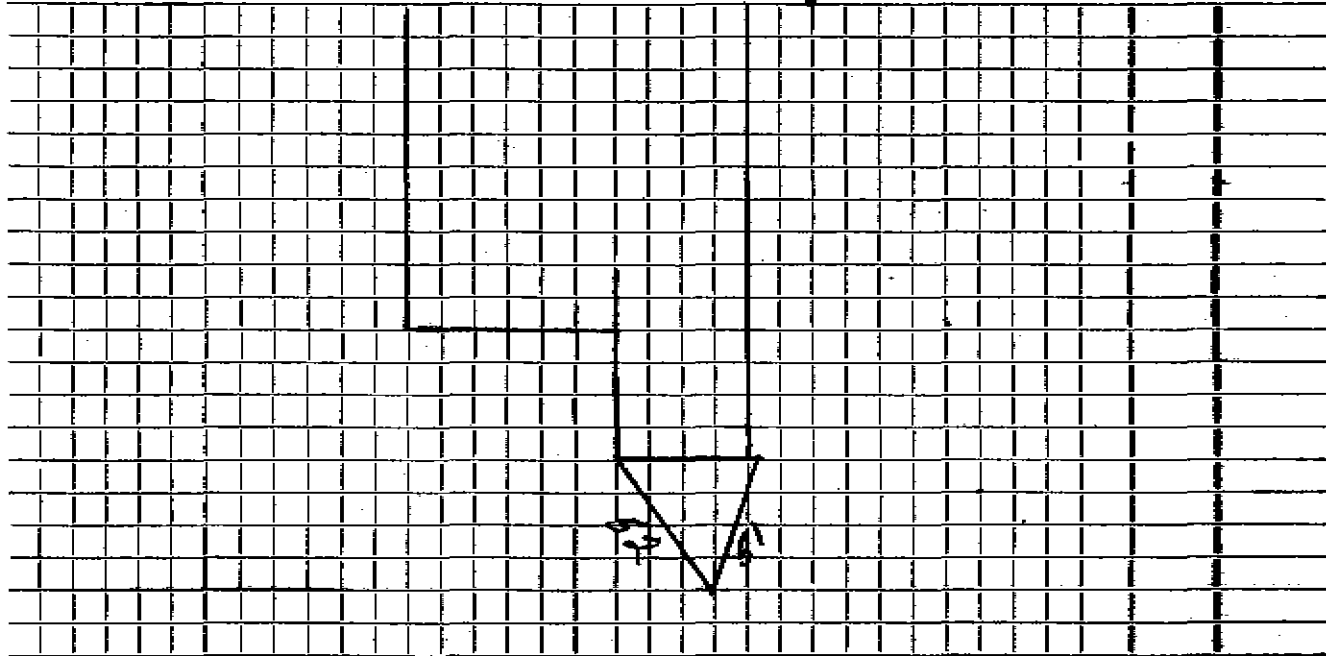

Connection made in ..... Street.

Work completed .....

Remarks: .....  
.....  
.....