




DATE 9/29/22

TOWN OF LEXINGTON — BOARD OF PUBLIC WORKS  
SEWER DIVISION

Sketch of Service Here

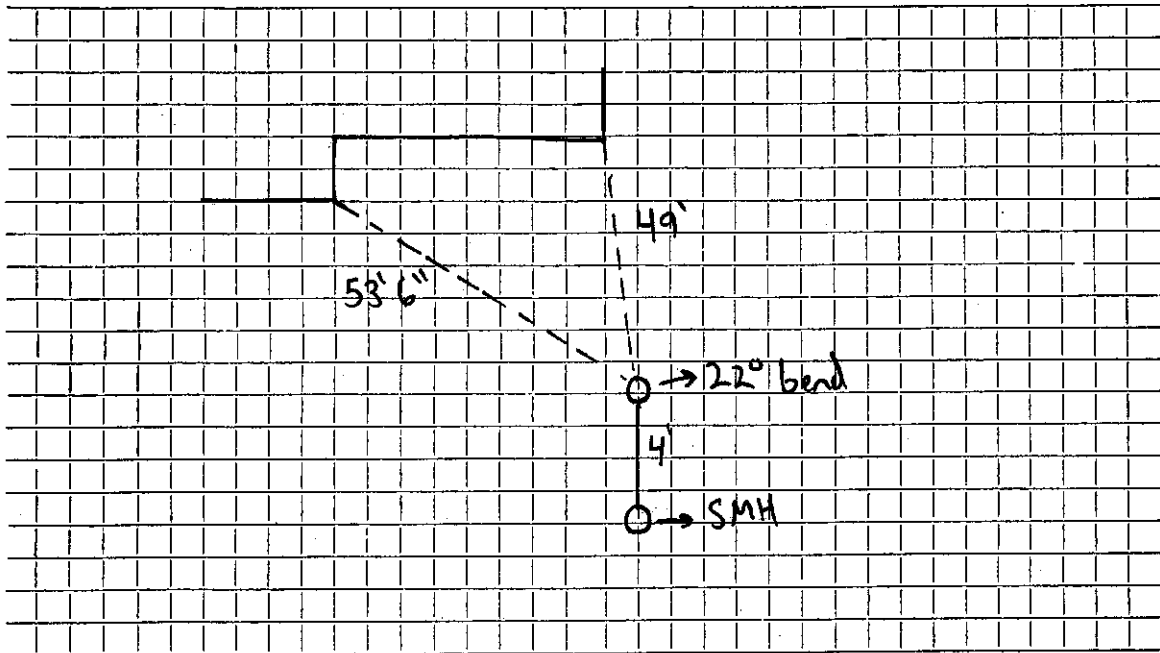

Connection made in ..... Street. Work completed .....

Remarks: INSTALLED BY LOVINO .....

Comms/Electric located 3 feet into the property from EOP. .....