

Name

Service No.

Address

22 Washington St

Location

Kind of Pipe

SDR Sch. 35 PVC

Size

6"

Size of Main

Repair

~~Renewal~~

New Service

Location

Date

Material

Amount

Total

Date

Amount

5/6/20

4" Sch. 40 Cleanout

7'

6" Sch. 35 SDR

PVC pipe


80'

6" Insert Tee

DATE 5/6/2020

TOWN OF LEXINGTON — BOARD OF PUBLIC WORKS
SEWER DIVISION

Sketch of Service Here

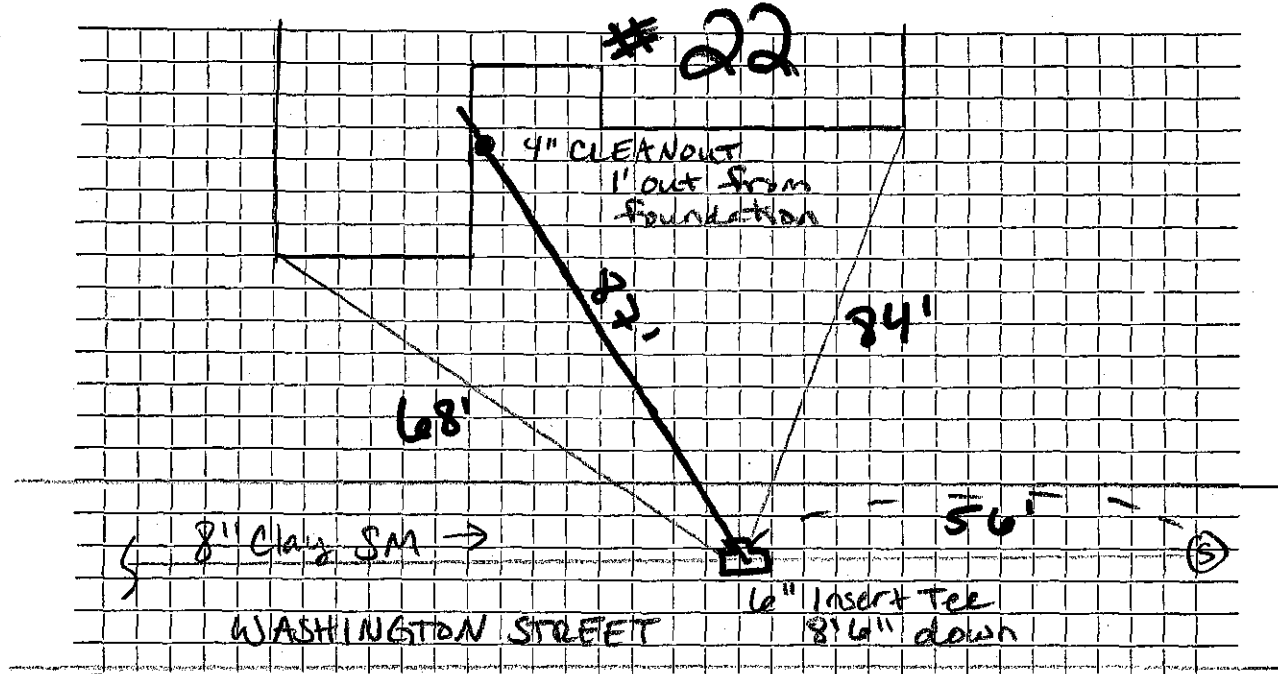

Connection made in ... Washington ... Street. Work completed

Remarks: 4" x 6" ferro 6' from foundation