

Name Robert Fernald

Service No. 81 1035

Address 4 Washington Street

Lexington, Mass.

Location 4 Washington Street

Kind of Pipe

Size 6"

Size of Main 8"

REPAIR WORK - New Service

Cor. 12-2-46

Location

Date	Material	Amount	Total	Date	Amount	
Sept. 12, '46	Labor	39 01		Sept. 7 '46	Hydrant	25 00
13, '46	"	16 50	55 51	Jan 8 '47	Sand	6 08
	10% Overhead		5 55			81 08
	54' - 6" Sewer Pipe @.269		14 53			
	Joint Compound		3 24			
	Trucking 3 hrs. @.75		2 25	9-9-49	Repair	
			81 08		20' 6" Sewer Pipe	
	Labor					

TOWN OF LEXINGTON—DEPT. OF PUBLIC WORKS

SEWER DIVISION

DATE


NO.

The undersigned applies for the construction of a particular sewer connecting No. Street and hereby agrees to comply with the Rules and Regulations governing the construction and use of Particular Sewers, as now or at any future time established by the Board of Selectmen.

Am't of estimate \$.....

Am't Paid \$.....

..... Owner

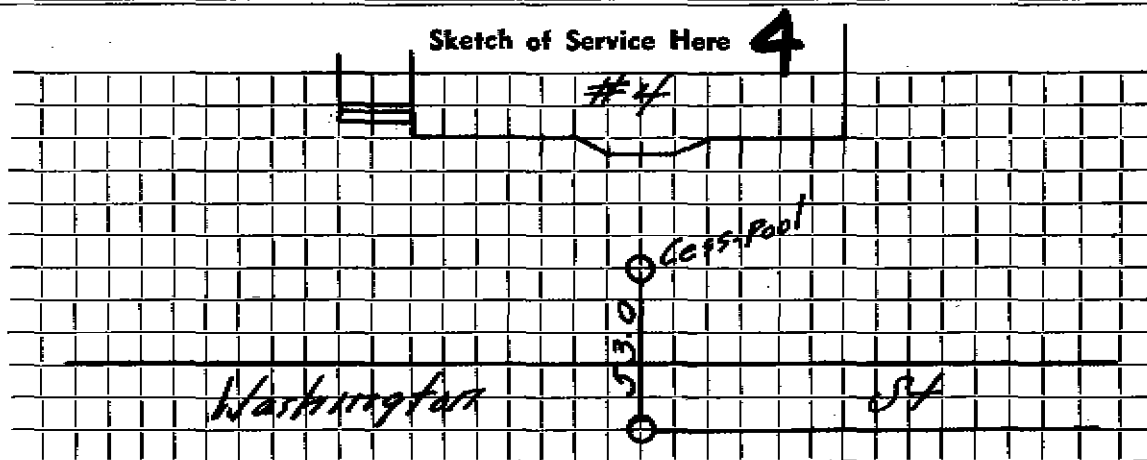

Connection made in Street.

Work completed 19..

Remarks: