

Name Charles Peck

Service No. ²⁵ 1027

Address 5 Washington Street

Lexington, Mass.

Location 5 Washington Street

Kind of Pipe

Size 6"

Size of Main 8"

~~Repair~~ ~~Renewal~~ — New Service

Location

Date	Material	Amount	Total	Date	Amount
June 4, 47	Labor	51 69	51 69	May 26 '47	125 00
	10% Overhead		5 17	Nov 29 '47	42 92
	46' - 6" Sewer Pipe @ .26		11 96	10-29-53	82 08
	Joint Compound		2 76	8' 6" Sewer Pipe	
	Patching 9 x 3		9 00		
	Trucking 2 hrs. @ .75		1 50		
			82 08		
	Labor			7/10/67	Roots
	Com 11-24-67			9/11/68	Roots

TOWN OF LEXINGTON—DEPT. OF PUBLIC WORKS

SEWER DIVISION

DATE

NO.

The undersigned applies for the construction of a particular sewer connecting No. Street and hereby agrees to comply with the Rules and Regulations governing the construction and use of Particular Sewers, as now or at any future time established by the Board of Selectmen.


Am't of estimate \$.....

Am't Paid \$.....

..... Owner

Sketch of Service Here

5

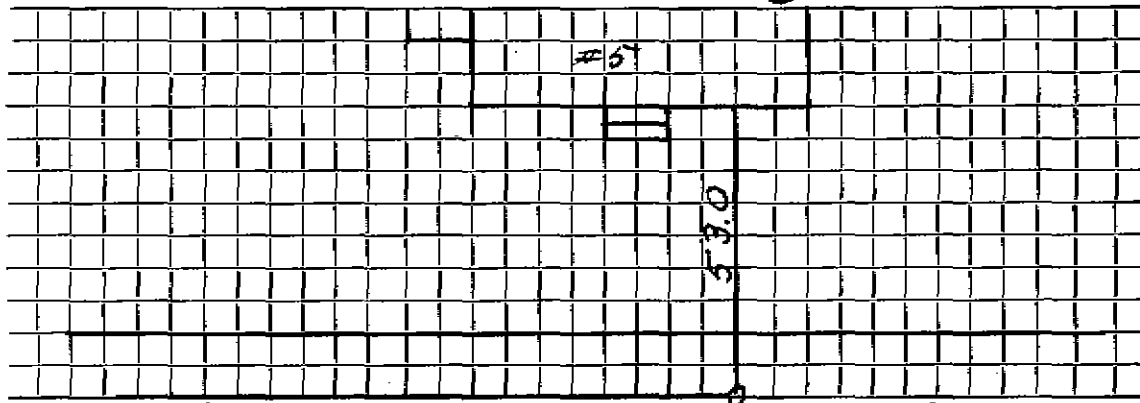

Connection made in Street.

Work completed 19..

Remarks: