

TOWN OF LEXINGTON — BOARD OF PUBLIC WORKS


SEWER DIVISION

DATE _____

Sketch of Service Here

41

415 PC
415 SH WITH
GRAVEL

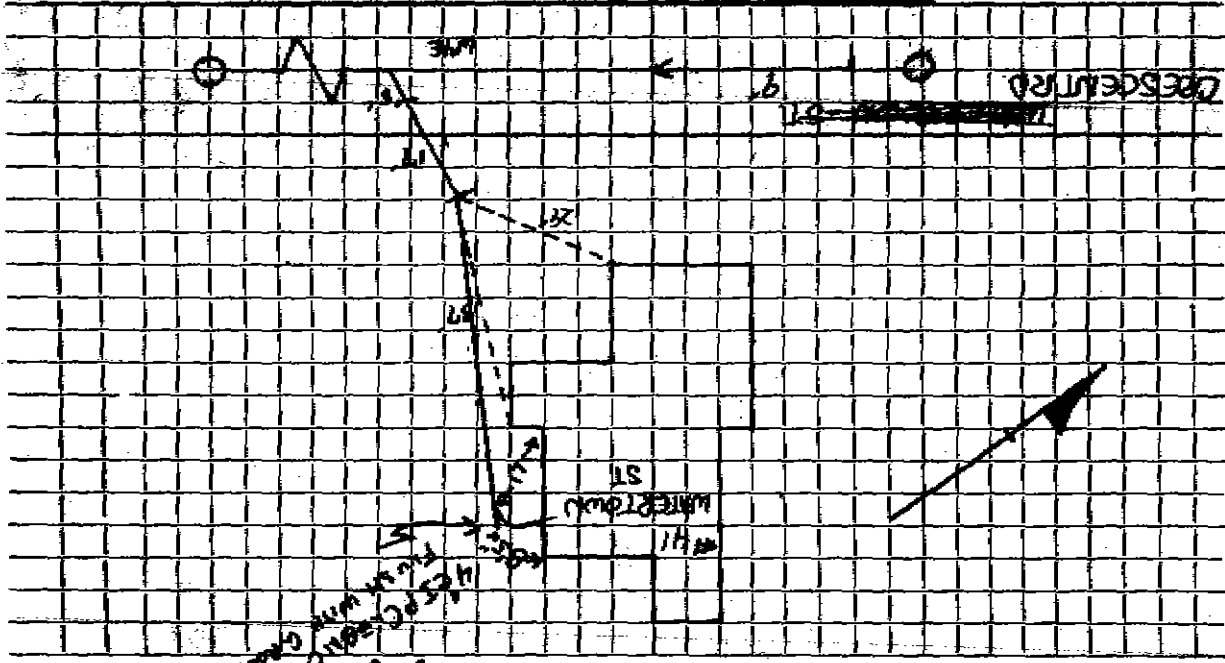

Work completed

Street.

Connection made in

Remarks: