

Name **William F. McGonagle**

Service No. **2**

Address **28 Watertown Street**

28 WATER TOWN STREET

Location

Kind of Pipe **David Eagle Permit #206**

Size **6"**

Size of Main **8"**

~~Repair Street~~ **New Service W.O. #9526**


Location **MAY 17 1965**

| Date | Material | Amount | Total | Date | Amount |
|------------------|---------------------------|--------|-------|---------|----------------|
| 22-65 | CURB TO MAIN | | | | |
| | Labor | 44.13 | | 1-23-65 | Deposit 100.00 |
| | 10% C.H. | 4.44 | 48.87 | 5-17-65 | Retard 26.34 |
| | 10' 6" Transite pipe @.82 | | 8.20 | | 73.66 |
| | 1 90° Transite Elbow | | 4.09 | | |
| | 1 hr. Town Shovel | | 6.50 | | |
| | 2 hrs. Town Truck @3.00 | | 6.00 | | |
| | | | 73.66 | | |
| 12-65 | 53' 6" Transite pipe | | | | |

TOWN OF LEXINGTON — BOARD OF PUBLIC WORKS

SEWER DIVISION

Sketch of Service Here **28**

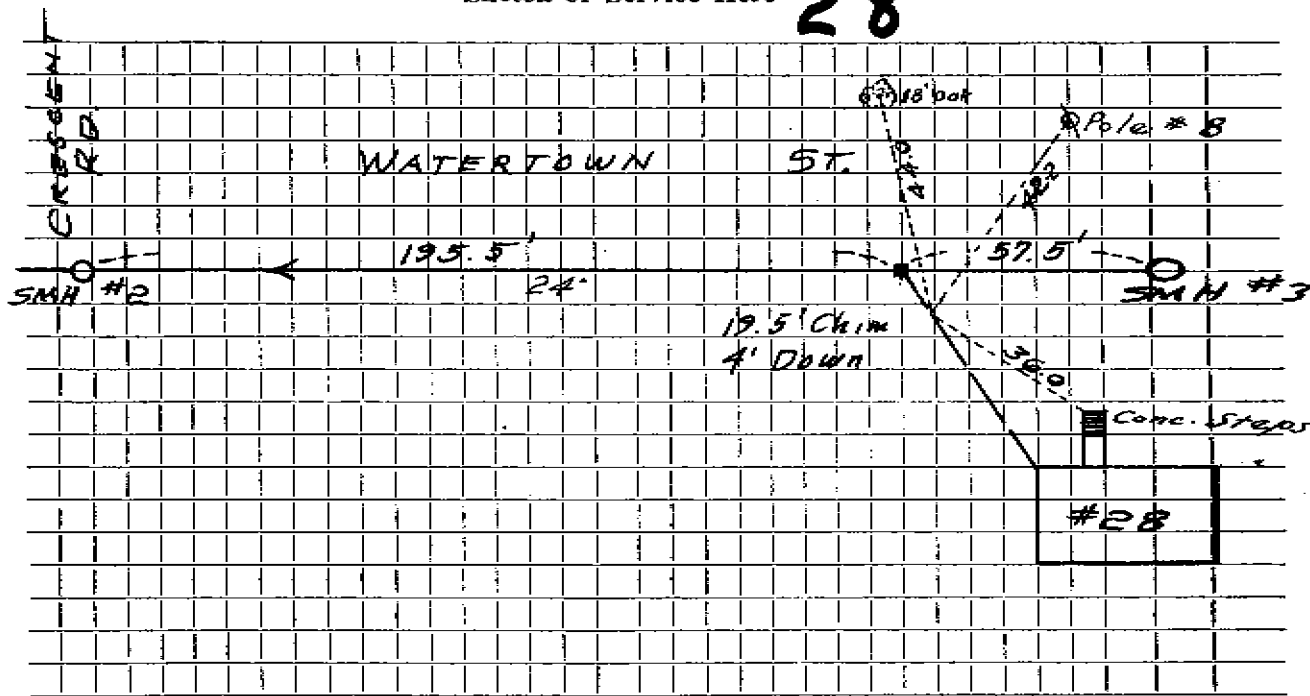

Connection made in Street. Work completed

Remarks:
.....
.....