

Name Walter Radford

Service No.

Address 30A Watertown Street

30A WATER TOWN STREET

Location

Kind of Pipe

Size 6"

Size of Main 8"

Repair—Renewal—New Service Sylvester & Son Permit #305

Location

Date		Material	Amount	Total	Date	Amount
-2-65	58'	6" Transite pipe				


DATE \_\_\_\_\_

TOWN OF LEXINGTON — BOARD OF PUBLIC WORKS

SEWER DIVISION

Sketch of Service Here

**30A**

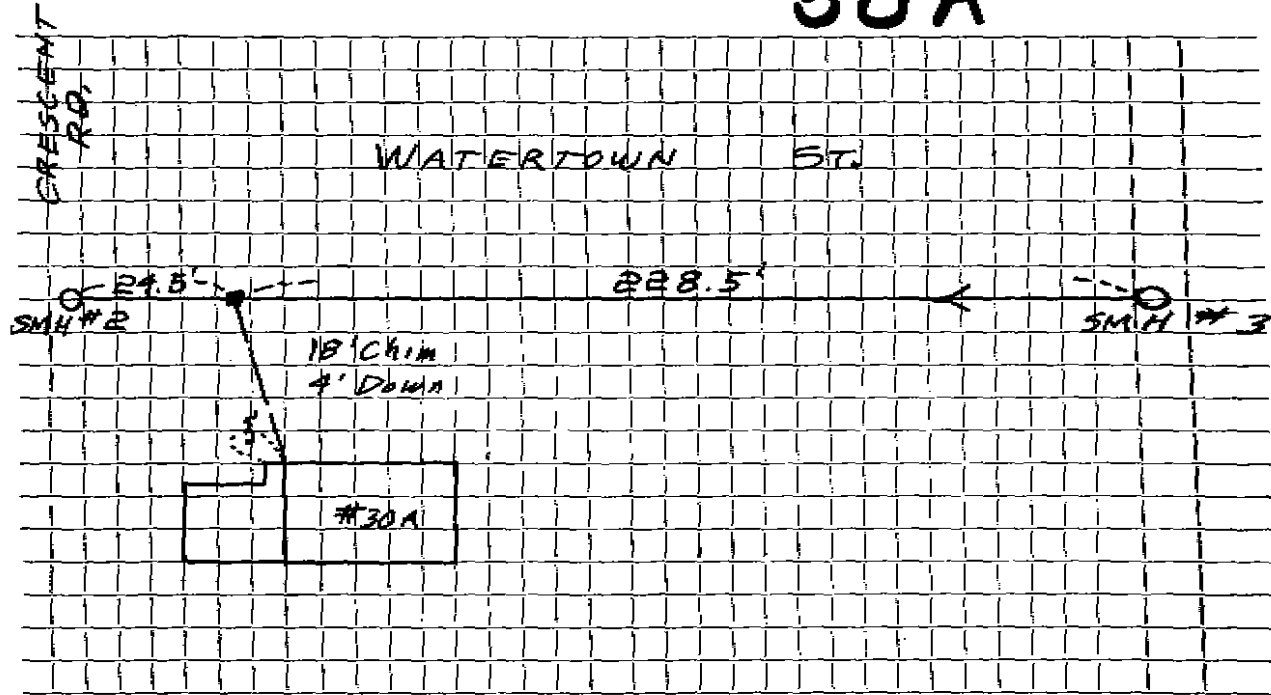

Connection made in ..... Street. Work completed .....

Remarks: .....  
.....  
.....