

Name Mr. Kramer

Service No.

Address 32 Watertown Street

32 WATER TOWN STREET

Location

Kind of Pipe

Size 6"

Size of Main 8"

Repair—Renewal—New Service Suburbanite #1409

Location

Date		Material	Amount	Total	Date	Amount
4-69	66'	6" Transite pipe				
	5'	4" Cast Iron pipe				




DATE _____

TOWN OF LEXINGTON — BOARD OF PUBLIC WORKS
SEWER DIVISION

Sketch of Service Here

32

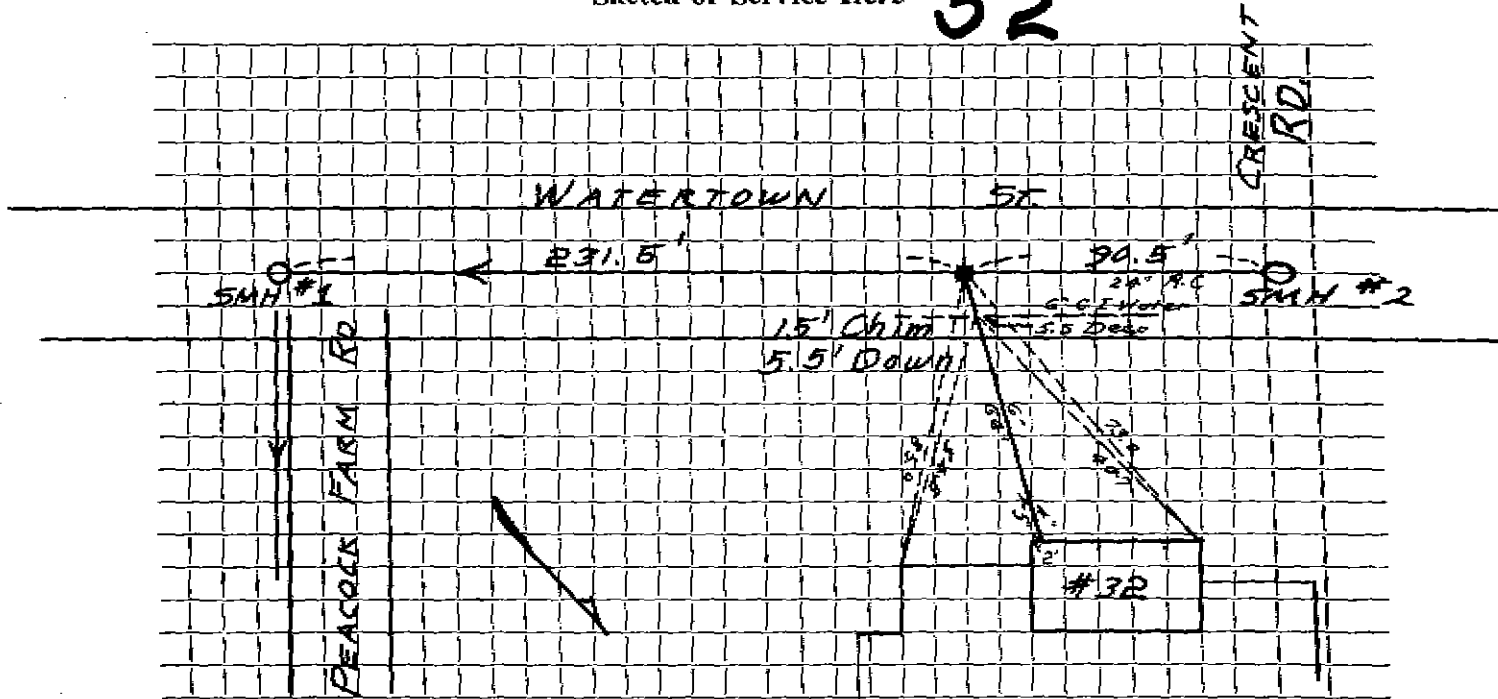

Connection made in Street. Work completed

Remarks:

.....

.....