

Serving No. 70

Name Inspection District
Address of 37 WATER TOWN ST.

37 Water Town Street
Location

Kind of Pipe AC
Size of Pipe 6"
Size of Main 3"

REPAIRS - New Service -
Hickland & Shaw #3549

Location NOV 2, 1980

Date	Material	Amount	Total	Date	Amount
2/18/78	30' 6" AC	\$14	\$970	11-5-80	Deposit
11-23-80	66' x 6" PVC Pipe				
10	x 4" GIPipe				
1	6" x 4" Rubber Demur				


DATE _____

TOWN OF LEXINGTON — BOARD OF PUBLIC WORKS

SEWER DIVISION

Sketch of Service Here

37

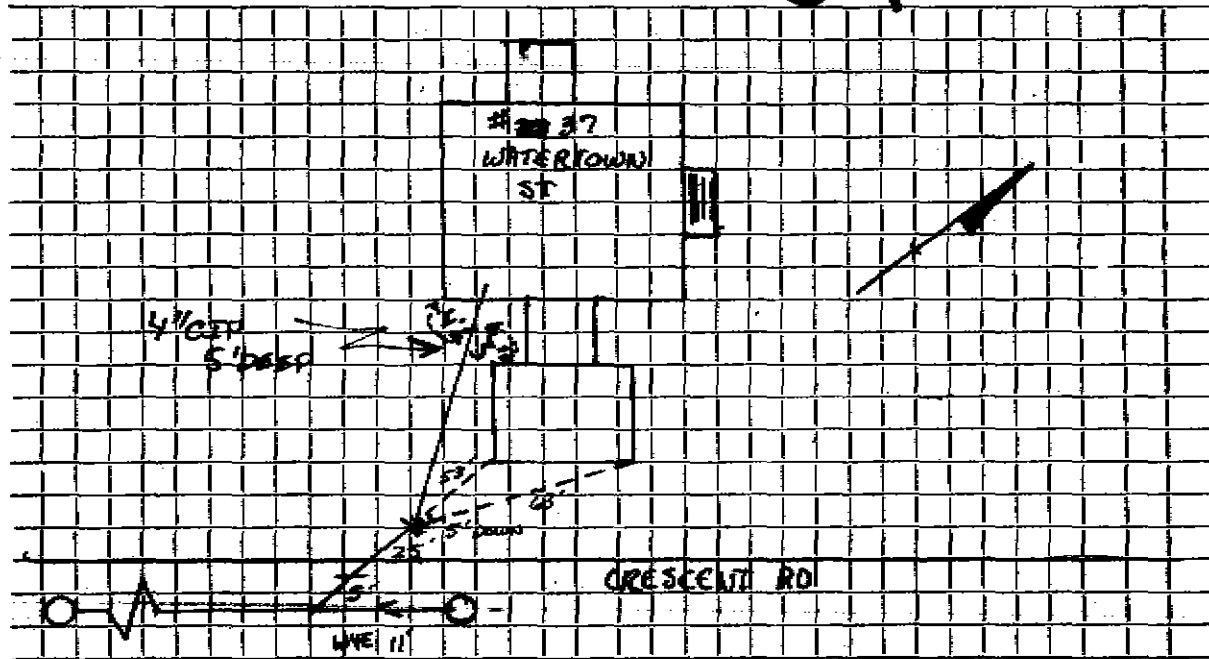

Connection made in Street. Work completed

Remarks:

.....

.....