

Name Paul J. Kennedy

Service No. 216

Address 6 Watertown Street

6 Water Town Street

Location

Kind of Pipe Valeri Const. Co. Permit #A79

Size 6"

Size of Main 8"

~~Repair~~ New Service

Location MAY 2 1966

Date		Material	Amount	Total	Date	Amount
65	22'	6" Transite pipe @ \$5.00		110.00	11-1-65	110.00
1/20/65	33'	6" Transite pipe				


Repair P

DATE \_\_\_\_\_

TOWN OF LEXINGTON — BOARD OF PUBLIC WORKS

SEWER DIVISION

Sketch of Service Here **6**

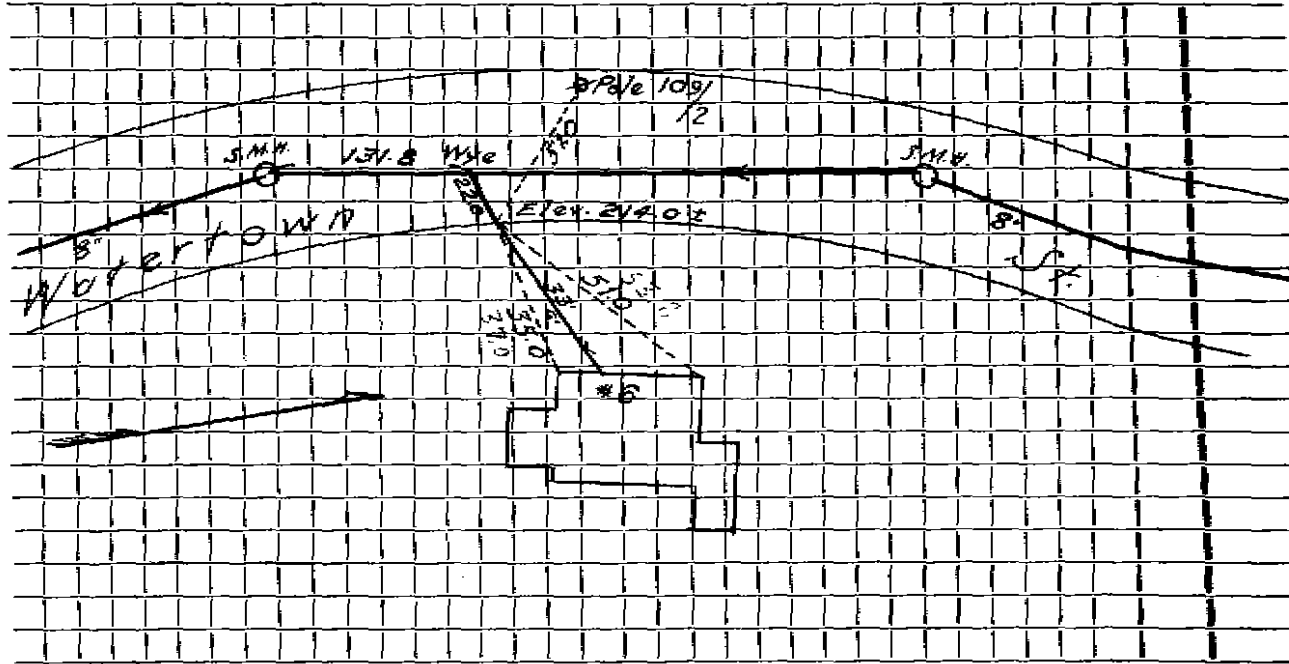

Connection made in ..... Street. Work completed .....

Remarks: .....  
.....  
.....