

Name

Lance Neumann

Service No.

Address 4 WATSON RD.

4 Watson Road

Location

Kind of Pipe PVC & CI

Size 4" & 6"

Size of Main 8"

Repair ~~General~~ - New Service

McKee #0614

Location

Date	Material	Amount	Total	Date	Amount
5/20/92	7 LF 4" CI				
	28 LF 8" PVC				
	4' x 4" FRANGO				
	6' x 4" FRANGO				


DATE _____

TOWN OF LEXINGTON — BOARD OF PUBLIC WORKS

SEWER DIVISION

Sketch of Service Here

4

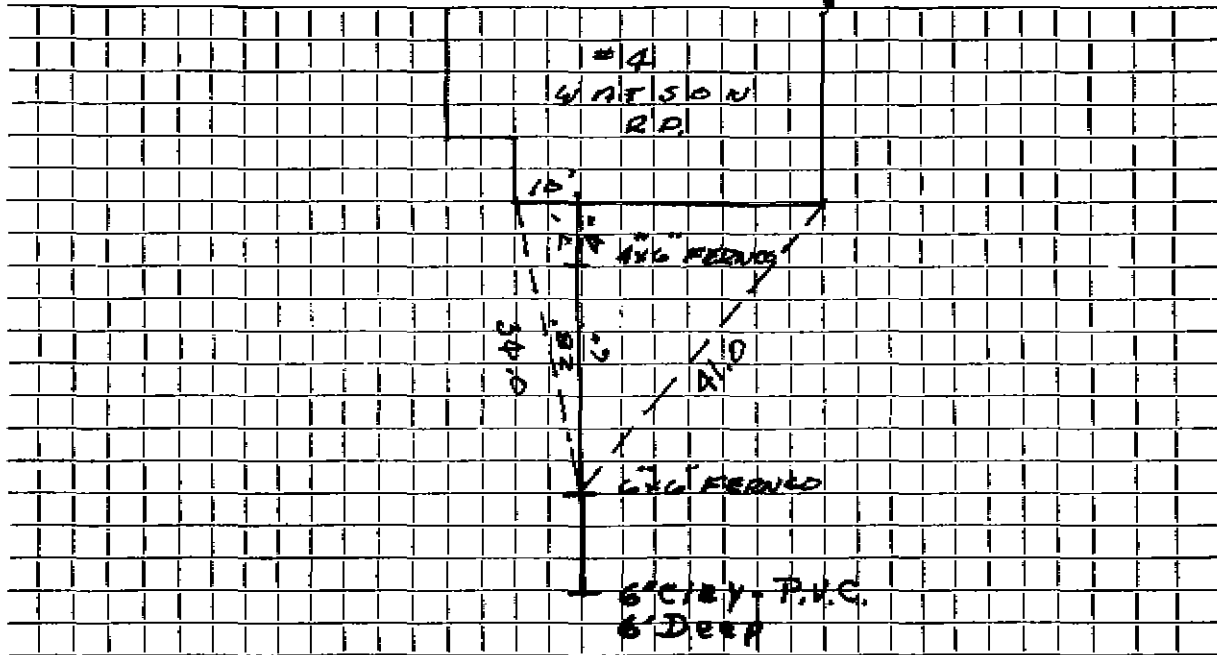

Connection made in WATSON RD. Street. Work completed

Remarks: B. McKEE CONTR.

Original Service 6-16-31 (41'-6" Sewer Pipe) (Repair 11-12-91 12' P.V.C.)