


DATE 7/6/22

TOWN OF LEXINGTON — BOARD OF PUBLIC WORKS
SEWER DIVISION

Sketch of Service Here

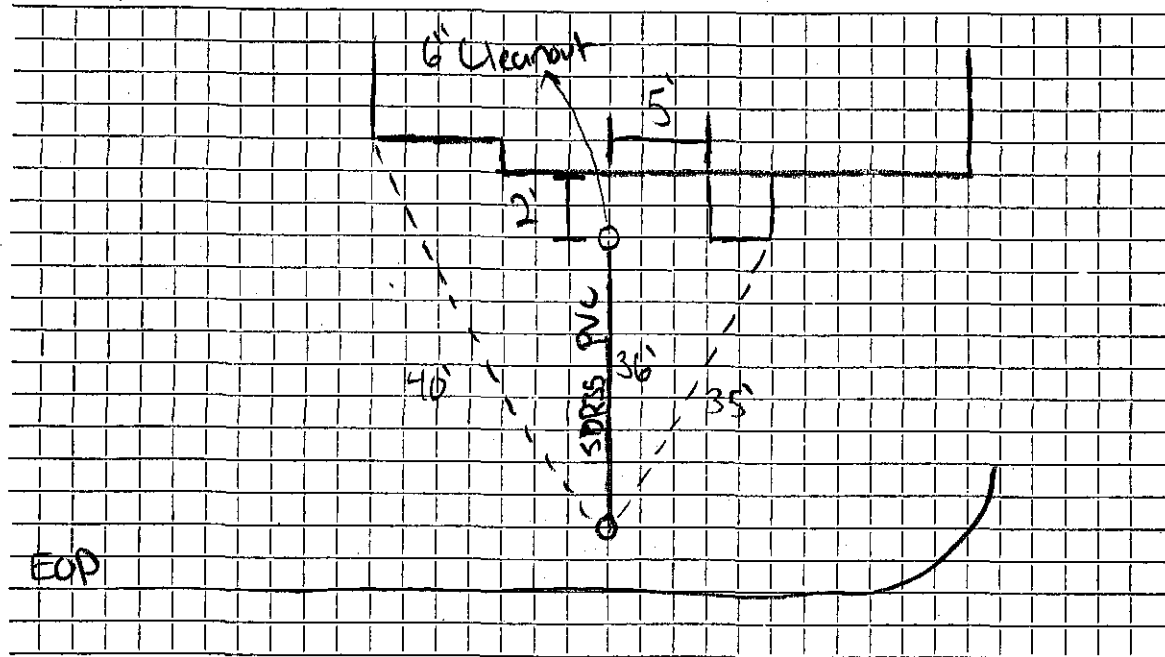

EOP

Connection made in Street. Work completed

Remarks: INSTALLED BY DAVE SANTO
SEWER LOCATED BELOW WATER SERVICE