

Name **Wesley Nelson**

Service No. **117**

Address **8 Watson Road**

Lot 10

Lexington 8 Watson Road Location

Kind of Pipe **Eagle #1258**

Size **6"**

Size of Main **8"**

~~REPAIR~~ **New Service**

Service to curb - to be charged when connected.

Location **MAY 27 1968**

Date	Material	Amount	Total	Date	Amount
7/50	Labor	25 80		11/21/68	58 56
	10% overhead	2 58	28 38	<i>Deposit</i>	
	18' - 6" sewer pipe		5 04		
	1 - 6" elbow		1 56		
	joint compound		1 08		
	3 hrs. Littlefield shovel		21 00		
	2 hrs. trucking		1 50		
			58 56		
4-68	29' 6" Transite pipe				
	10' 4" Cast Iron pipe				
	Labor				

TOWN OF LEXINGTON—DEPT. OF PUBLIC WORKS

SEWER DIVISION

DATE

NO.

The undersigned applies for the construction of a particular sewer connecting No. Street and hereby agrees to comply with the Rules and Regulations governing the construction and use of Particular Sewers, as now or at any future time established by the Board of Selectmen.


Am't of estimate \$.....

Am't Paid \$.....

..... Owner

Sketch of Service Here

8

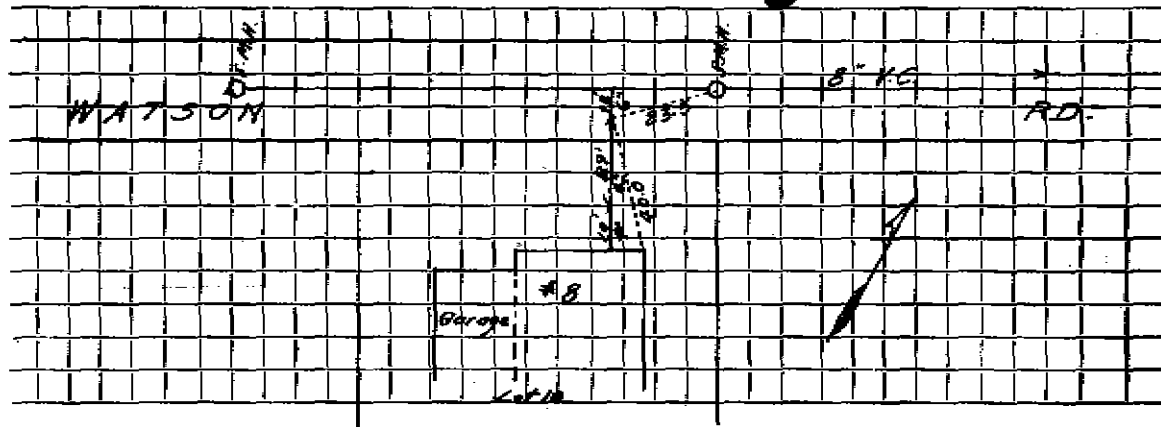

Connection made in Street.

Work completed 19..

Remarks: