




DATE \_\_\_\_\_

TOWN OF LEXINGTON — BOARD OF PUBLIC WORKS

SEWER DIVISION

10 Sketch of Service Here

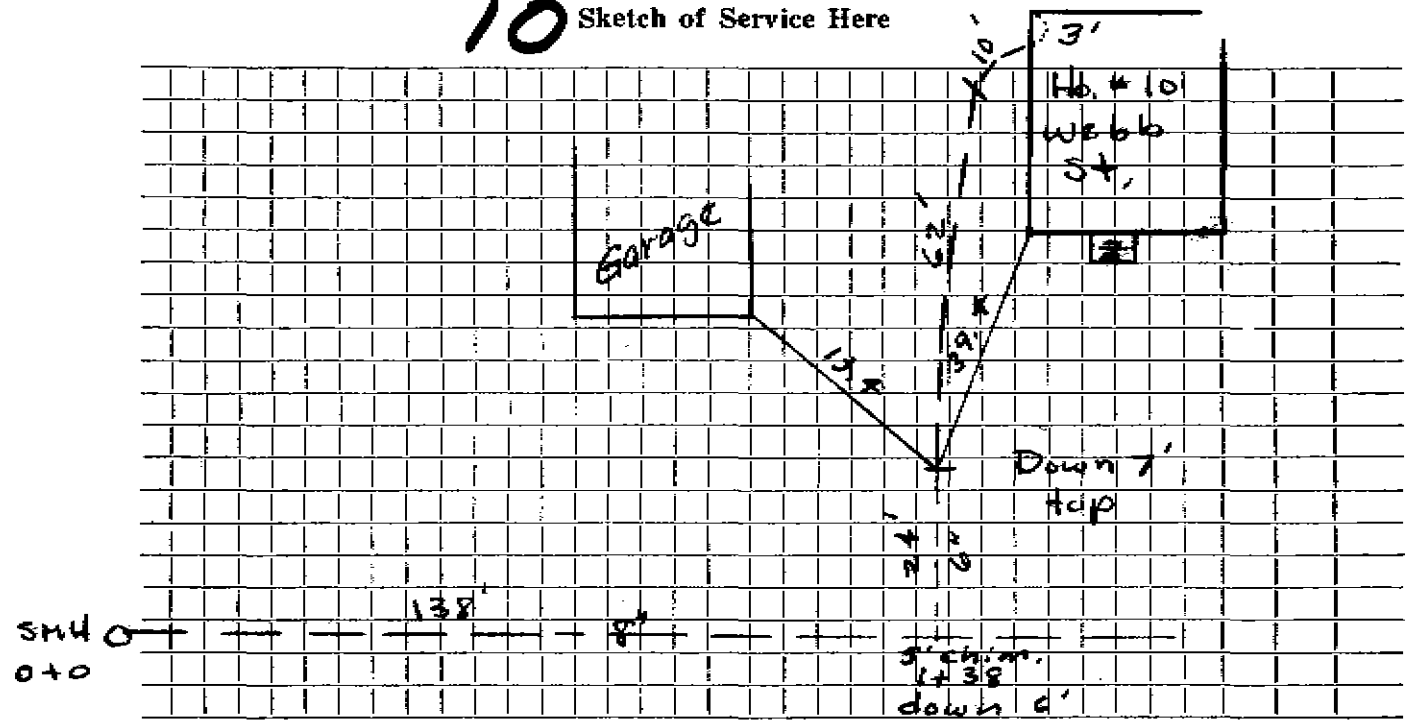

Connection made in Webb St. Street.

Work completed 12/24

Remarks: .....