

Service No.

4

Name ~~Webb~~

Address 16 Webb St.

16 Webb Street

Location

Kind of Pipe

Size 6"

Size of Main 8"

Repair—Renewal—New Service


Location

Date	Material	Amount	Total	Date	Amount
				8-10-73	
				24'	



SEWER DIVISION

Sketch of Service Here
 16

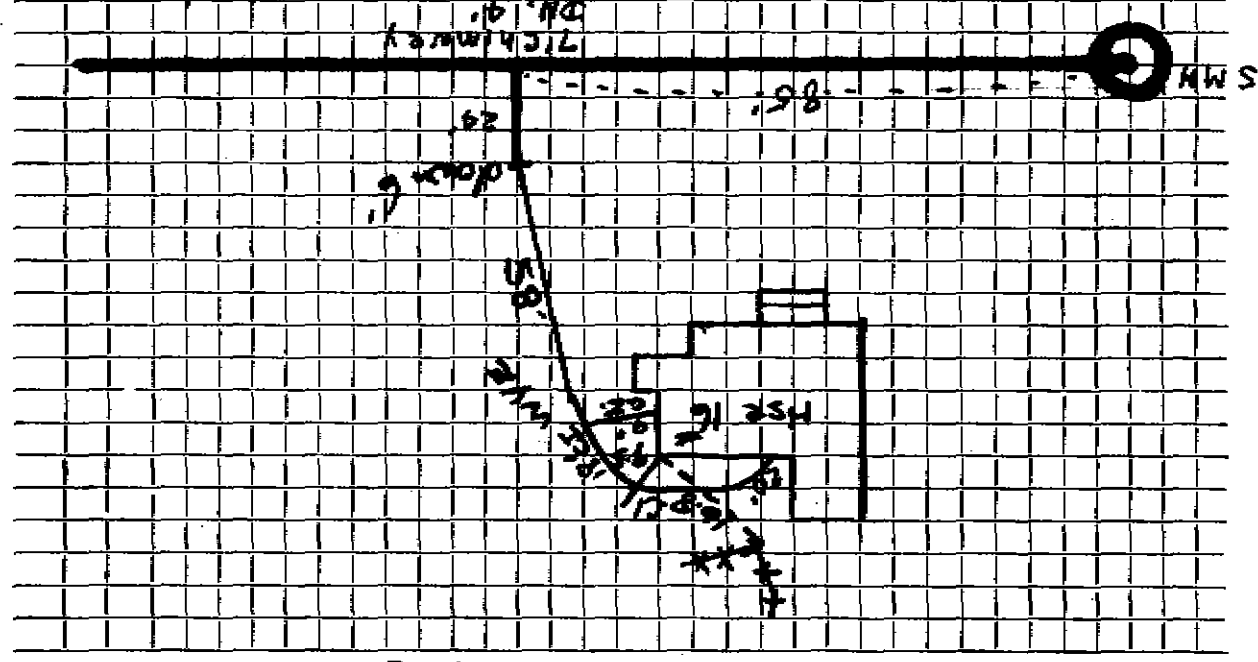

Connection made in 16 Webb St Street.
 Work completed 9/18/74
 Remarks: