


DATE 11/29/90

TOWN OF LEXINGTON — BOARD OF PUBLIC WORKS

SEWER DIVISION

20 WEBB ST.

Sketch of Service Here 20

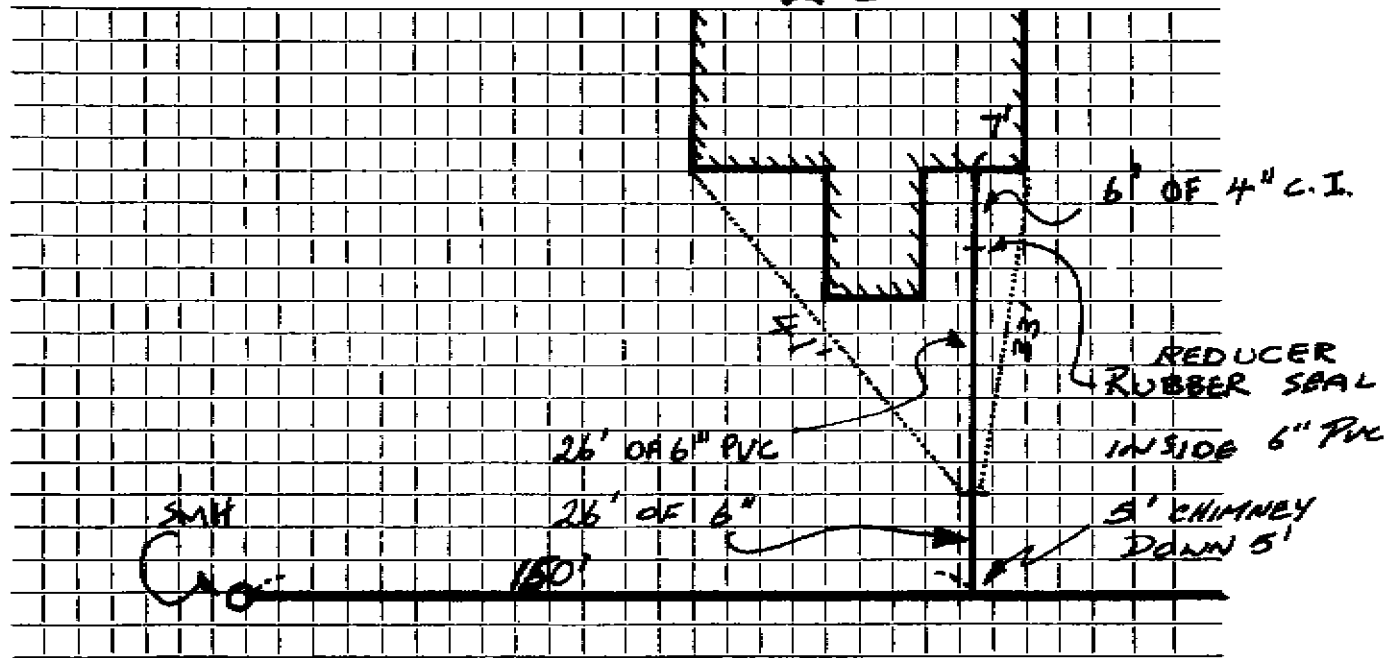

Connection made in WEBB Street. Work completed

Remarks:
.....
.....