

Name ROHTI & POONAM AROA

Service No.

Address #21 WEBB STREET

21 Webb Street

Location

Kind of Pipe

Size 6" *Manholes* Size of Main 8"

Repair—Renewal—New Service SEPTIC ABANDONMENT - PERMIT NO. 0864 Location

Date	Material	Amount	Total	Date	Amount
9/6 96	50.5' - 6" PVC				
	WYE CLEANOUT			8-13-73	
	6"X6" FERRO			20' 6"	
	4"X6" FERRO				


DATE 6 SEPT. 1996

TOWN OF LEXINGTON — BOARD OF PUBLIC WORKS

SEWER DIVISION

Sketch of Service Here

21

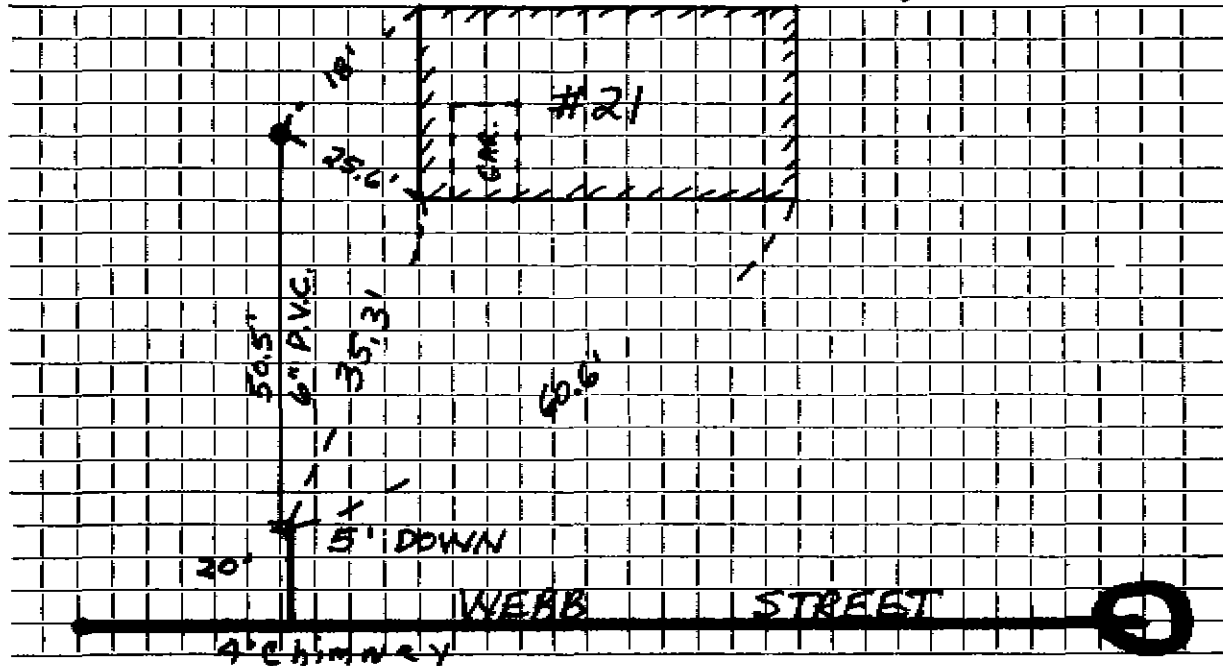

Connection made in WEBB 5.5' D.N. Street.

Work completed J.M. McLaughlin

Remarks:

BOOK 96-4

J.W.