


DATE _____

TOWN OF LEXINGTON — BOARD OF PUBLIC WORKS

SEWER DIVISION

Sketch of Service Here

22 +

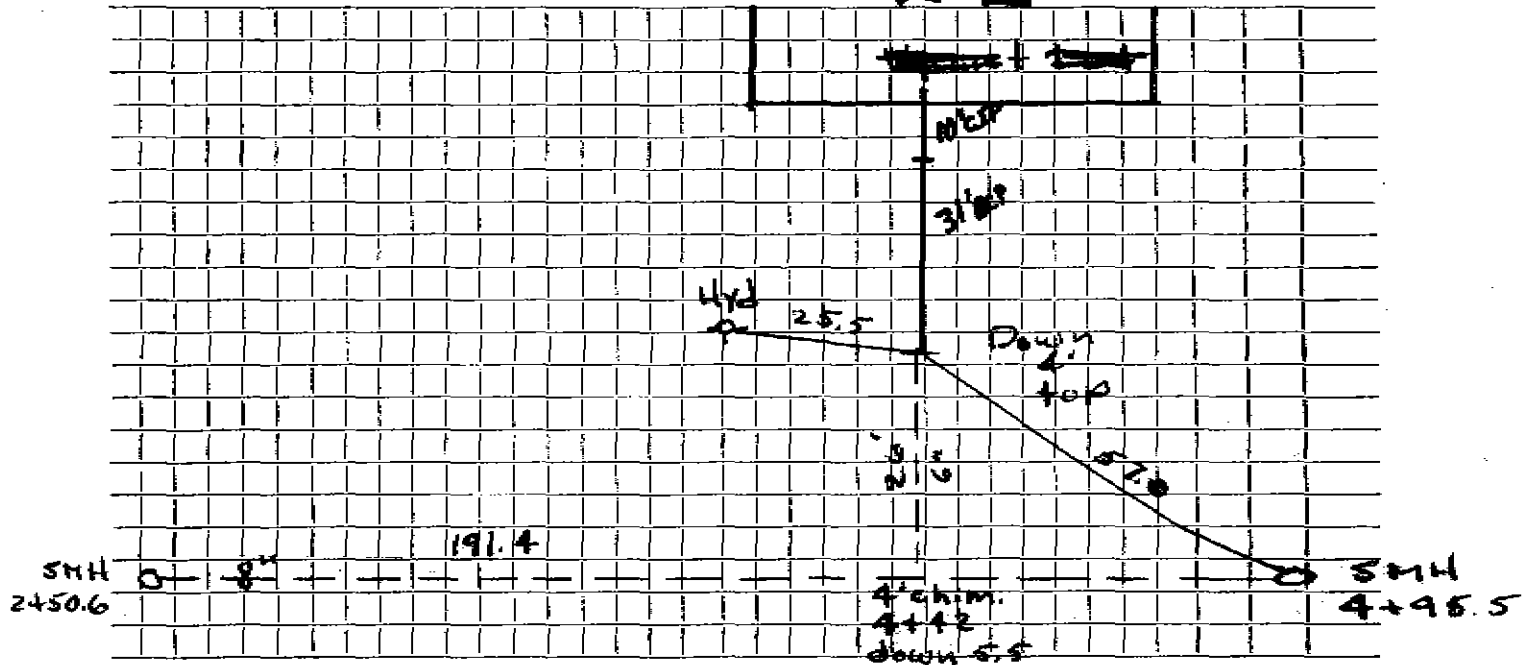

Connection made in Webb St. Street.

Work completed

Remarks: WATER & SEWER IN SAME TRENCH