

Name David Zaloga

Service No. 764 ¹³⁸

Address 24 Webb Street

24 Webb Street

Location

Kind of Pipe

Size 6"

Size of Main 8"

Repair—Renewal—New Service WO #3879 DeFelice Bros

Location FEB 13 1978

Date	Material	Amount	Total	Date	Amount
12/3/75	labor	32. 22		12-8-75	234.00
	10% OH	3. 22	35. 44	Deposit	
20'	6" Transite Pipe @	1.48	29. 60		
1	2' X 6" Nipple		5. 31		
1	6" cap.		3. 75		
2	tons 3/4" Stone @	3.50	7. 00		
1/2	bag cement		1. 50		
1	5' X 6" Nipple @	1.56 foot	7. 80		
2	tons cold patch		27. 40		
	Franch 15 X 3'6"		34. 20		
2	1/3 hour truck @	3.00	7. 00		
5	hour shovel @	6.50	32. 50		
8 1/2	hour compressor @	5.00	42. 50		
			234. 00		
2/17/82	40' 6" A.C.				
	8' 4" CI				


DATE _____

TOWN OF LEXINGTON — BOARD OF PUBLIC WORKS

SEWER DIVISION

Sketch of Service Here

24

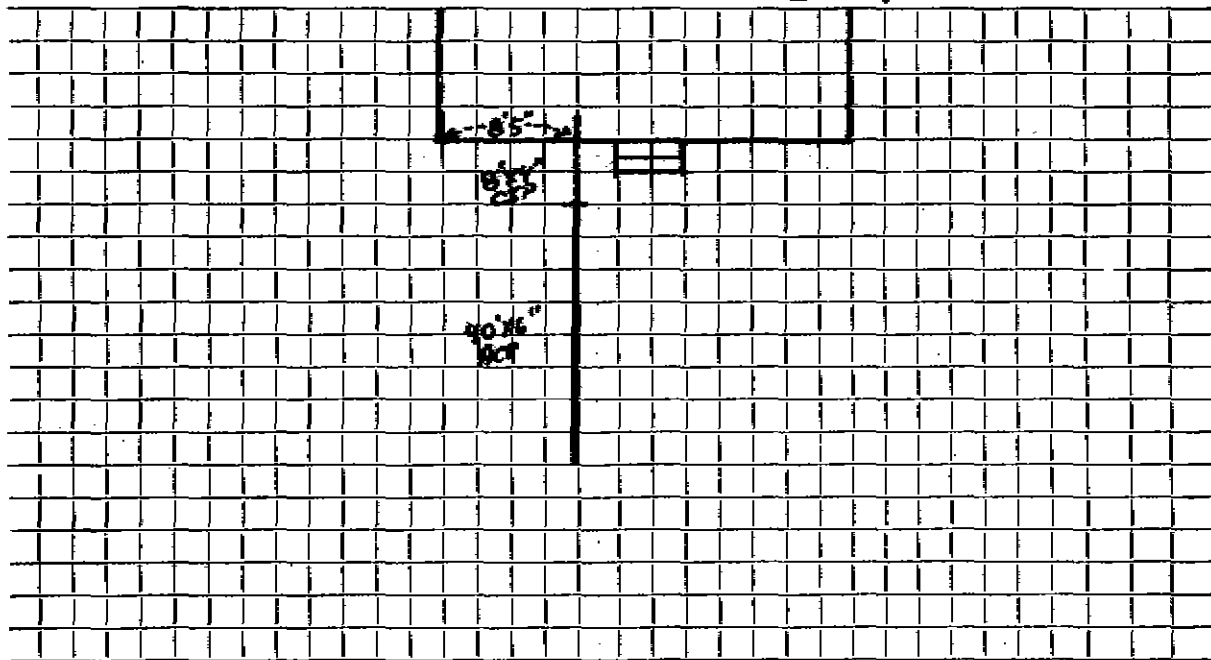

Connection made in Street. Work completed

Remarks: WATER & SEWER IN SAME TRENCH

.....
.....