


DATE _____

TOWN OF LEXINGTON — BOARD OF PUBLIC WORKS

SEWER DIVISION

Sketch of Service Here **26**

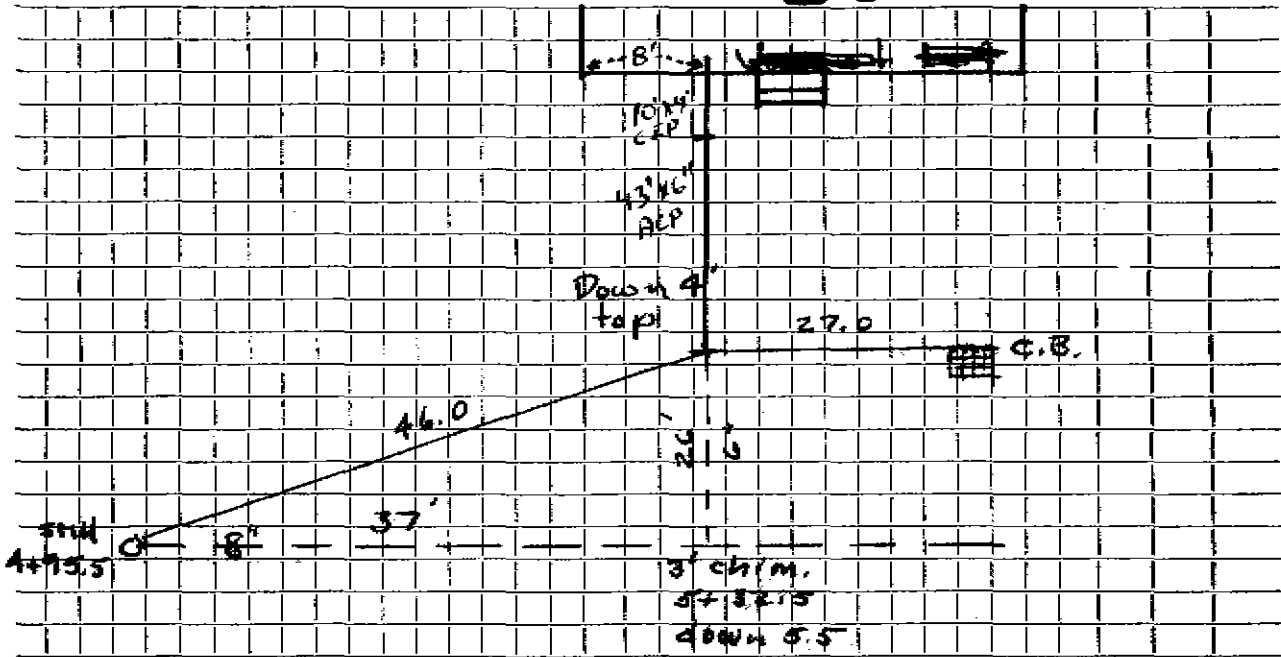

Connection made in Webb St. Street. Work completed

Remarks: WATER & SEWER IN SAME TRUNK