

Name Alvin Maillet

Service No. XX 129

Address ~~28~~ Webb St.

28 Webb Street

Location

Kind of Pipe ACP

Size 6"

Size of Main 8"

Repair—Renewal—New Service

DeFlice Bros. #2771

Location

FEB 13 1970


Date	Material	Amount	Total	Date	Amount
9 13	25' @ 9.00	225.00		11-4-75	Deposit
20/75	34' 6" Transite Pipe				
	10' 4" Cast Iron Pipe				
13/75	labor	32.22			
	10%OH	3.22	35.44		
	20' 6" Transite Pipe @ 1.48		29.60		
	1 2' X 6" nipple		5.31		
	1 6" Cap		3.75		
	2 tons 3/4" Stone @3.50		7.00		
	Trench 15 X 3'6"		34.20		
	2 1/3 hour truck @ 3.00		7.00		
	5 hr. shovel @ 6.50		32.50		
	8 1/2 hr. compressor @ 5.00		42.50		
			234.00		

DATE _____

TOWN OF LEXINGTON — BOARD OF PUBLIC WORKS

SEWER DIVISION

Sketch of Service Here **28**

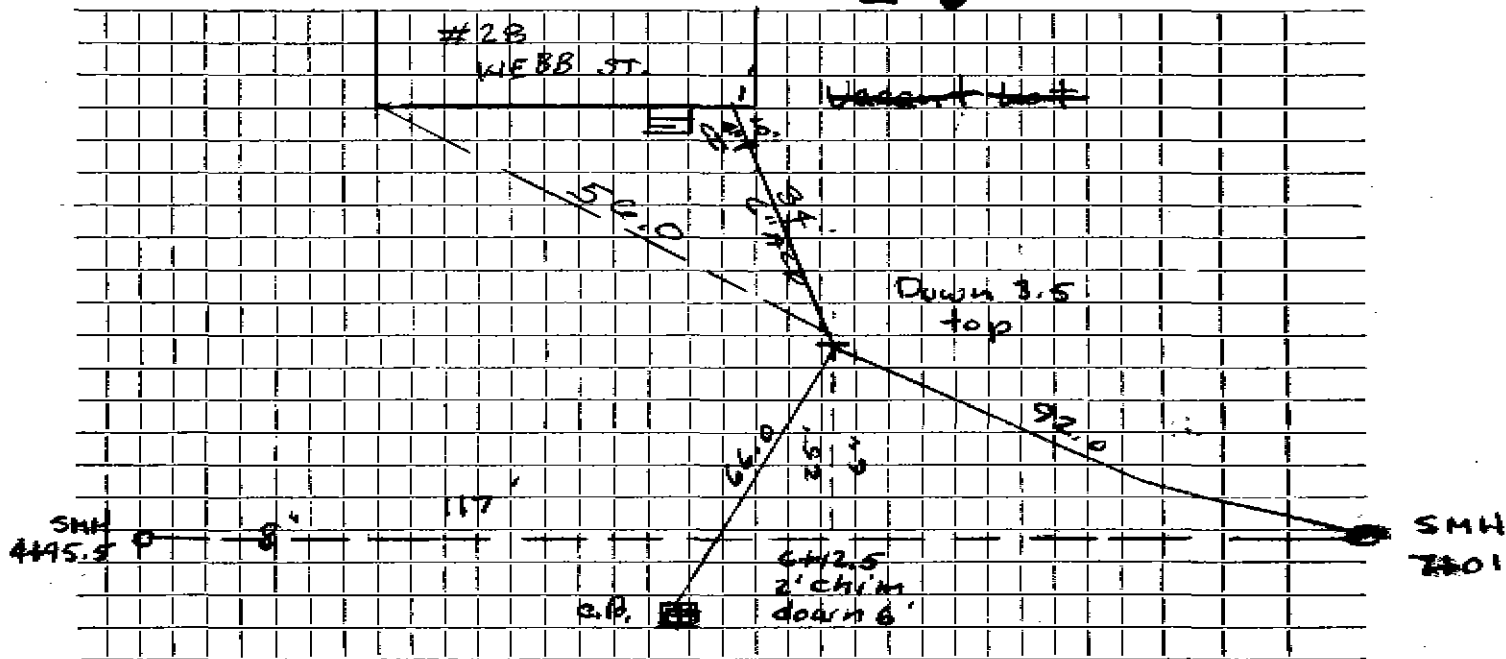

Connection made in Webb St. Street. Work completed

Remarks:

.....

.....