

Name Alvin Maillet

Service No. 149

Address 30 Webb Street

30 Webb Street

Location

Kind of Pipe

Size 6"

Size of Main 8"

Repair—Renewal—New Service

WO #3842

DIP/ice #2786

Location

FEB 13 1978


Date	Material	Amount	Total	Date	Amount
12/2/75	labor (NC)	240.72		12-5-75	100.00
	10%OH	24.87			
	10" Transite Pipe @ 1.48	14.80			
	20,500 lbs. 1½ stone @ 3.50	35.00			
	5' Nipple @ 1.56 ft.	7.80			
	1 Coupling	2.34			
	1 6" Plug	4.15			
	1 8 X 6 saddle	14.70			
	9 Yards Gravel @ 2.19	19.71			
	Patch 12 X 12 (NC)	96.00			
	4 hr. truck @ 3.00 (NC)	12.00			
	1 hr. loader (NC)	4.00			
	3 hr. shovel @ 6.50 (NC)	19.50			
	3 hr. pump @ .50	1.50			
12-15-75	45' 6" Transite	100.00			
	10' 4" Cast Iron				

TOWN OF LEXINGTON — BOARD OF PUBLIC WORKS

SEWER DIVISION

DATE \_\_\_\_\_

Sketch of Service Here **30**

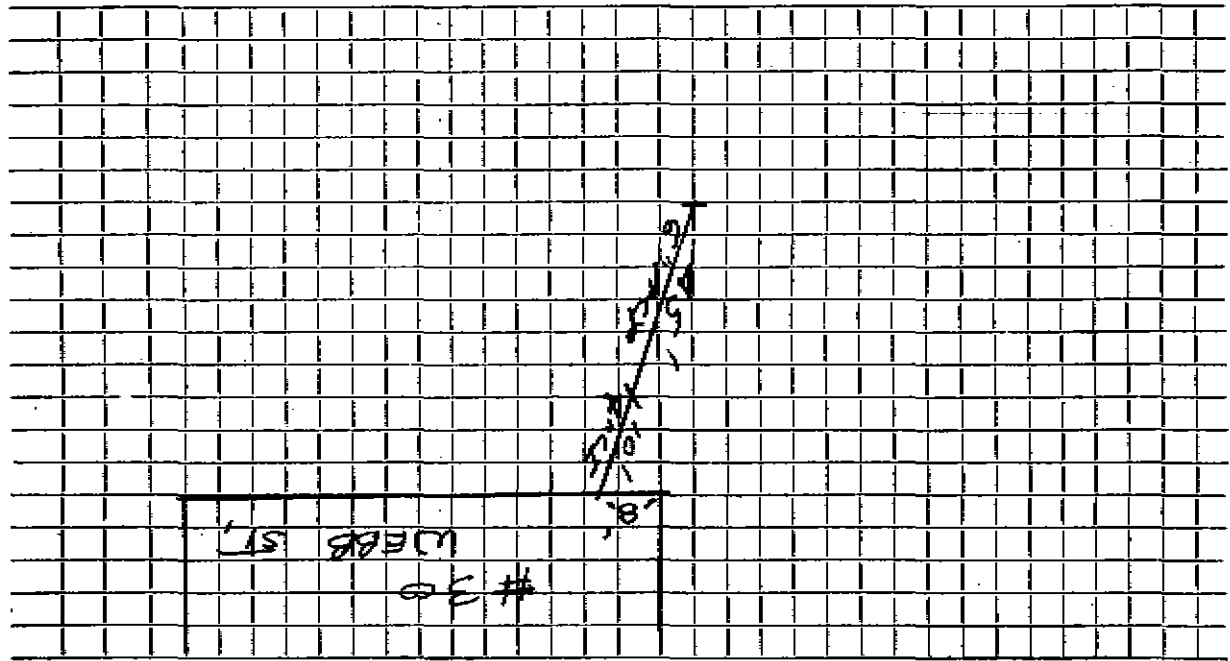

Work completed

Street

WEBB

Connection made in

Remarks: