


DATE _____

TOWN OF LEXINGTON — BOARD OF PUBLIC WORKS
SEWER DIVISION

Sketch of Service Here

34

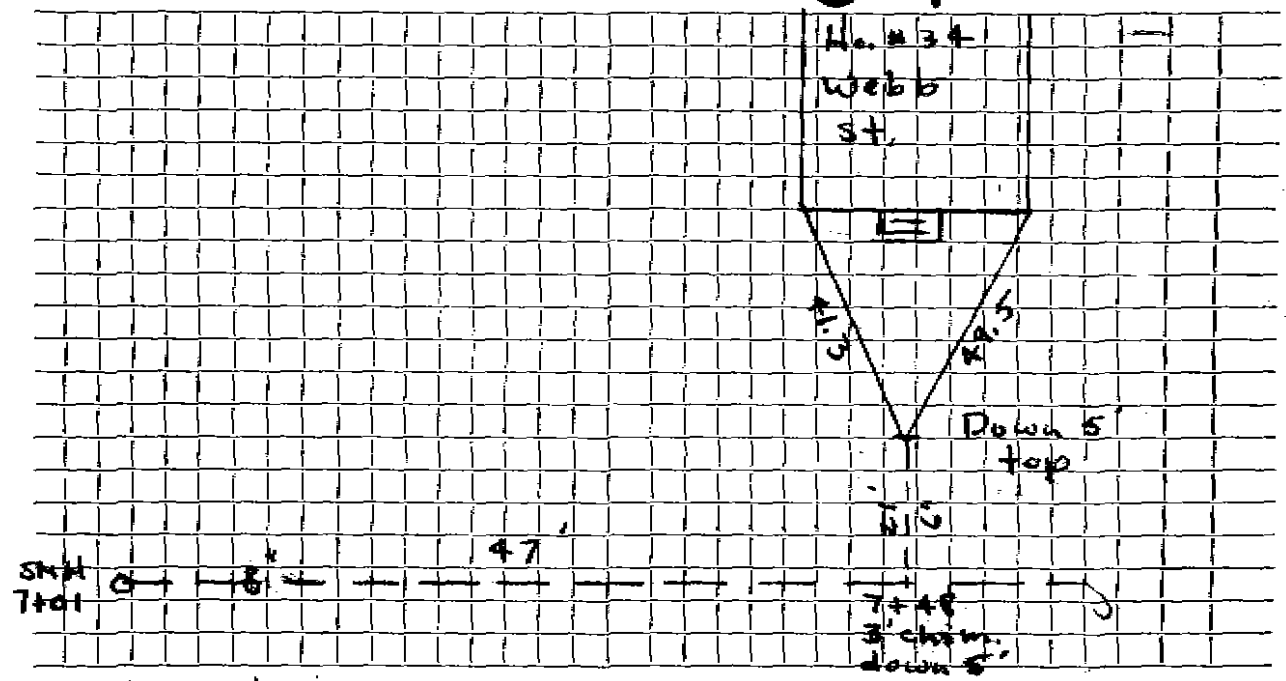

Connection made in Webb St. Street. Work completed

Remarks: