


DATE _____

TOWN OF LEXINGTON — BOARD OF PUBLIC WORKS

SEWER DIVISION

Sketch of Service Here

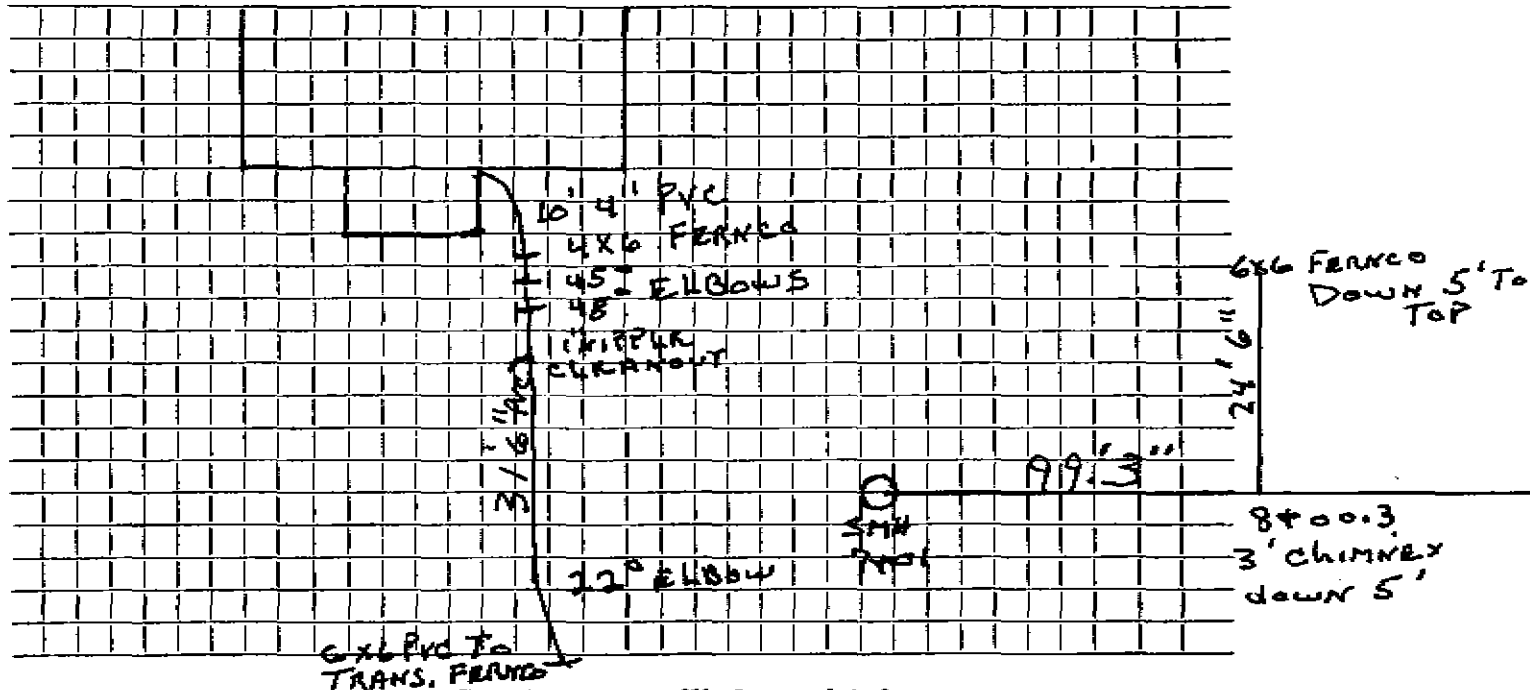

Connection made in Street. Work completed

Remarks: ..CLEAN OUT 8' FROM HOUSE
..INSTALLED BY KIRKLAND + SHAW