

Name Dorothy Bouley

Service No. 74) 17

Address 37 Webb St.

37 Webb Street

Location

Kind of Pipe ACP

Size 6"

Size of Main 8"

Repair—Renewal—New Service

Lexington Sewerage #2818

Location AUG 16 1976


Date		Material	Amount	Total	Date	Amount
-15	73	21' @ 9.00	189.00		4-13-76	Deposit 189.00
14/76	35	6" Transite Pipe				
	26	4" Cast Iron Pipe				

DATE _____

TOWN OF LEXINGTON — BOARD OF PUBLIC WORKS

SEWER DIVISION

Sketch of Service Here **37**

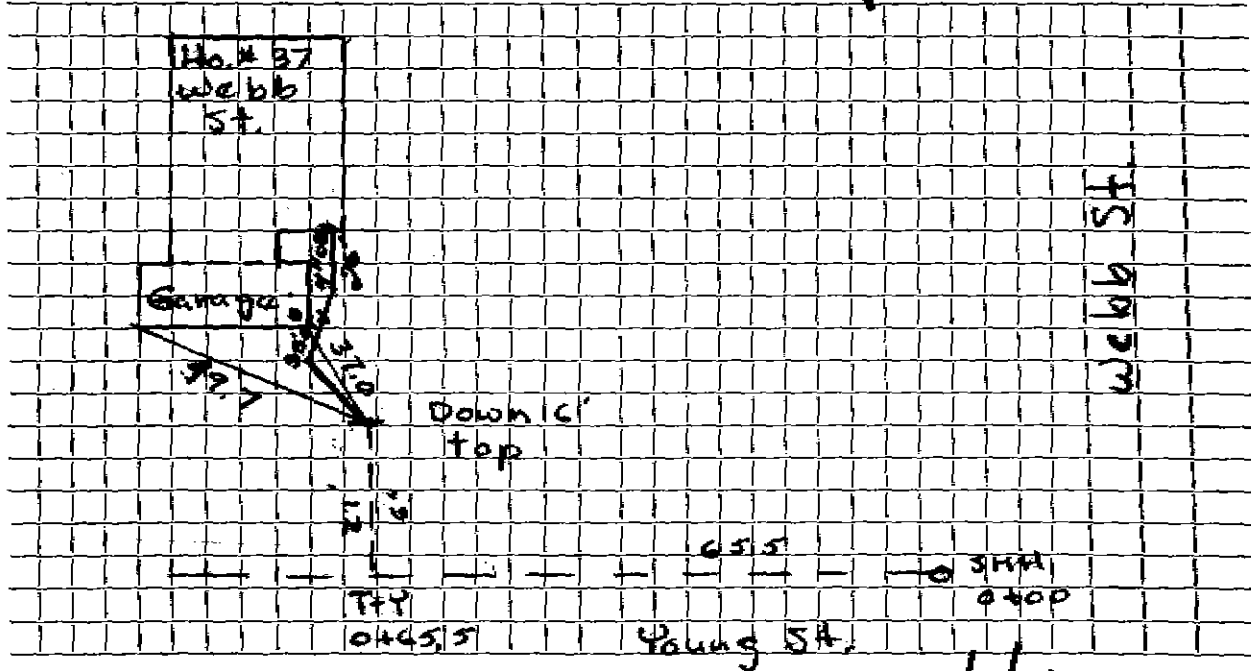

Connection made in Young St. Street. Work completed 5/4/76

Remarks: