




DATE \_\_\_\_\_

TOWN OF LEXINGTON — BOARD OF PUBLIC WORKS

SEWER DIVISION

Sketch of Service Here

38

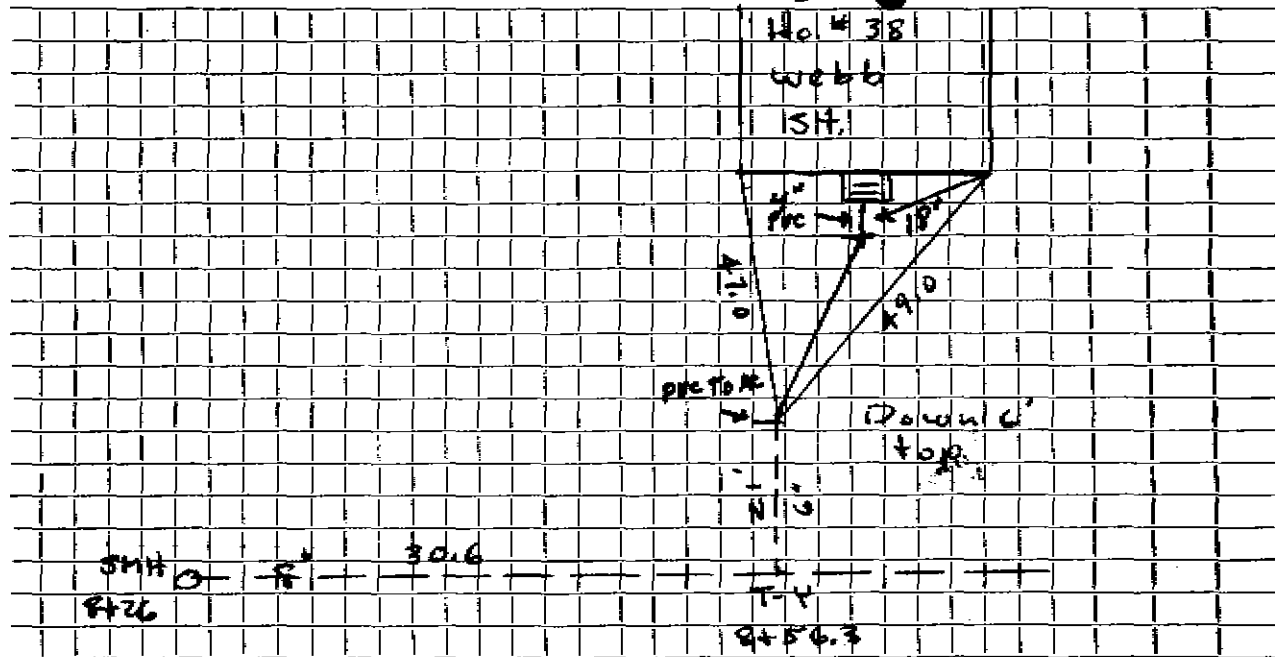

Connection made in Webb St. Street. Work completed .....

Remarks: Sewer Comes out in straight line no bends. .....