


DATE _____

TOWN OF LEXINGTON — BOARD OF PUBLIC WORKS
SEWER DIVISION

Sketch of Service Here

40

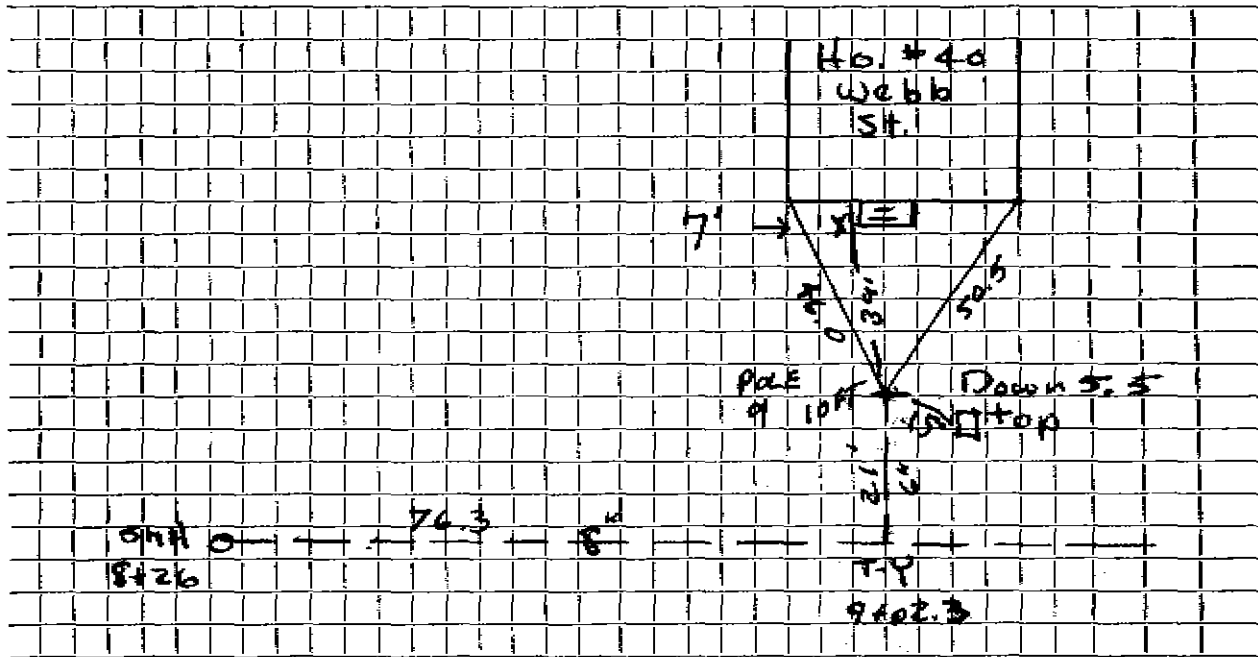

Connection made in webb st. Street. Work completed

Remarks: NEW SERVICE 1-7-00