




DATE \_\_\_\_\_

TOWN OF LEXINGTON — BOARD OF PUBLIC WORKS  
SEWER DIVISION

Sketch of Service Here **42**

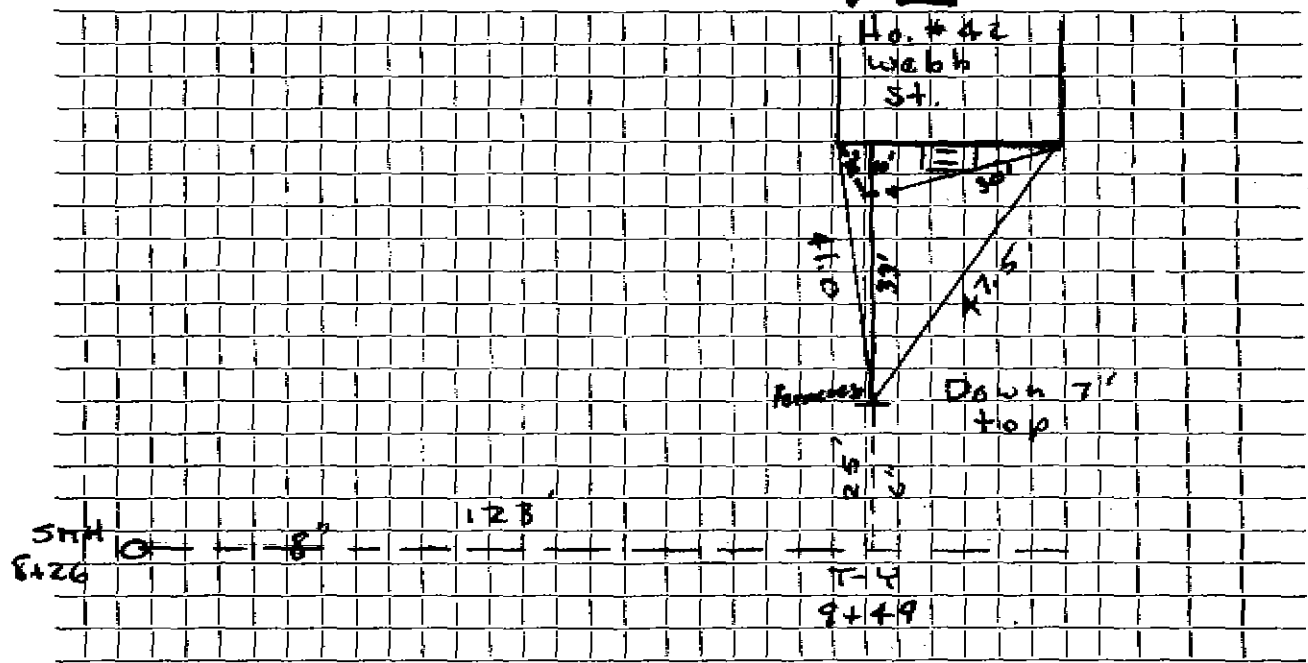

Connection made in Webb St. Street. Work completed .....

Remarks: .....

.....

.....