


DATE _____

TOWN OF LEXINGTON — BOARD OF PUBLIC WORKS

SEWER DIVISION

Sketch of Service Here **53**

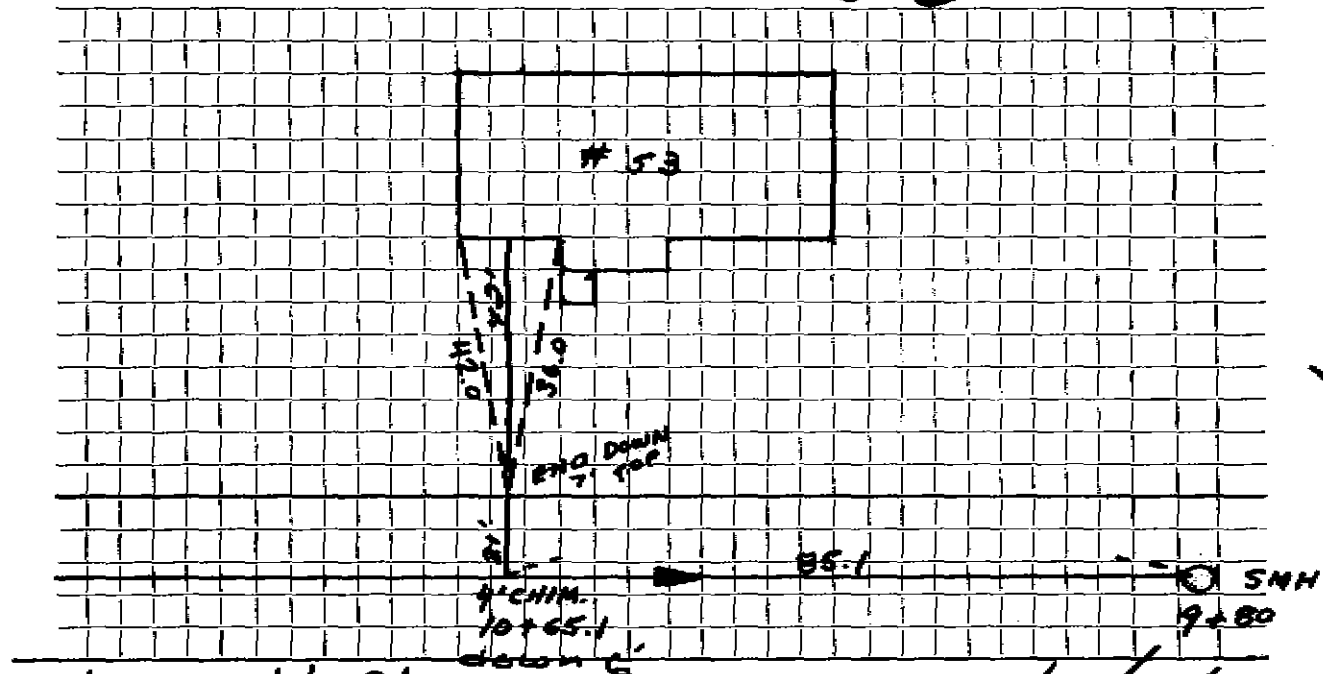

Connection made in **#53 Webb St** Street.

Work completed **11/18/74**

Remarks: _____

