

Name

Service No.

Address #57 Webb St.

57 Webb Street

Location

Kind of Pipe A.C.

Size 6"

Size of Main 8"

Repair—Renewal—New Service

Location

Date	Material	Amount	Total	Date	Amount
2/3/75	21' @ \$9.00	189.00			


18501

DATE _____

TOWN OF LEXINGTON — BOARD OF PUBLIC WORKS

SEWER DIVISION

Sketch of Service Here **57**

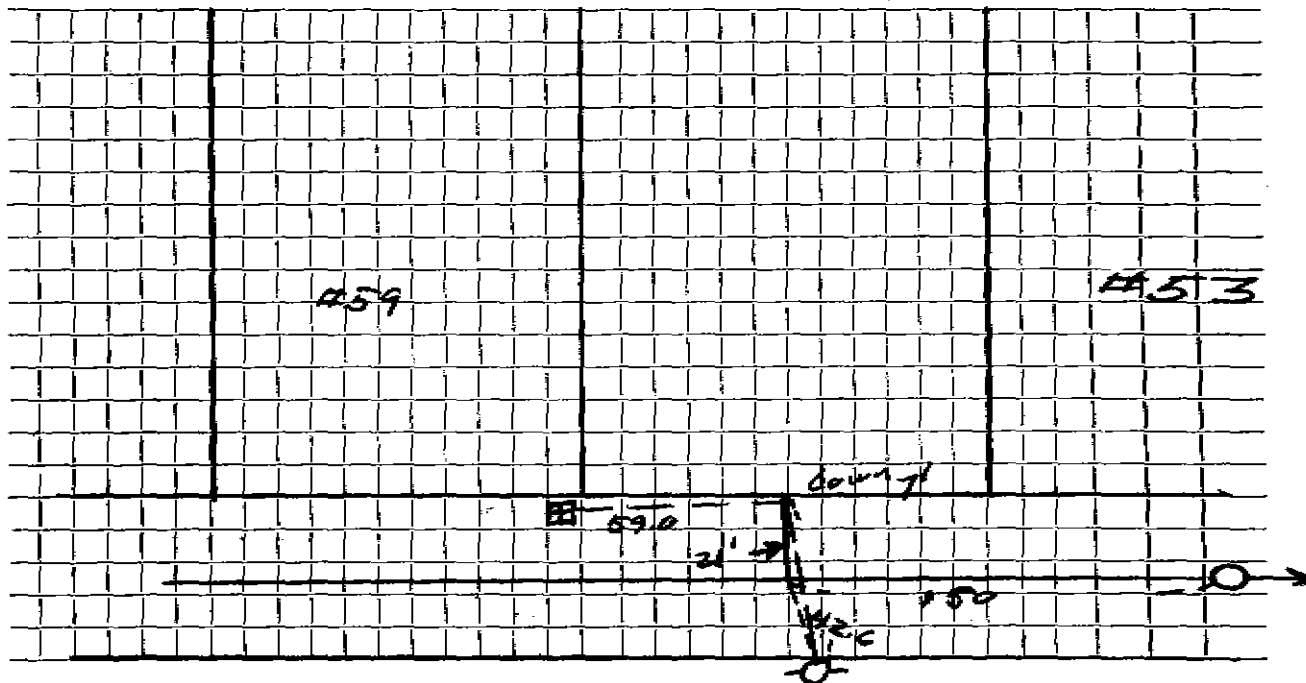

Connection made in Street. Work completed

Remarks:

.....

.....