




DATE \_\_\_\_\_

TOWN OF LEXINGTON — BOARD OF PUBLIC WORKS

SEWER DIVISION

Sketch of Service Here **60**

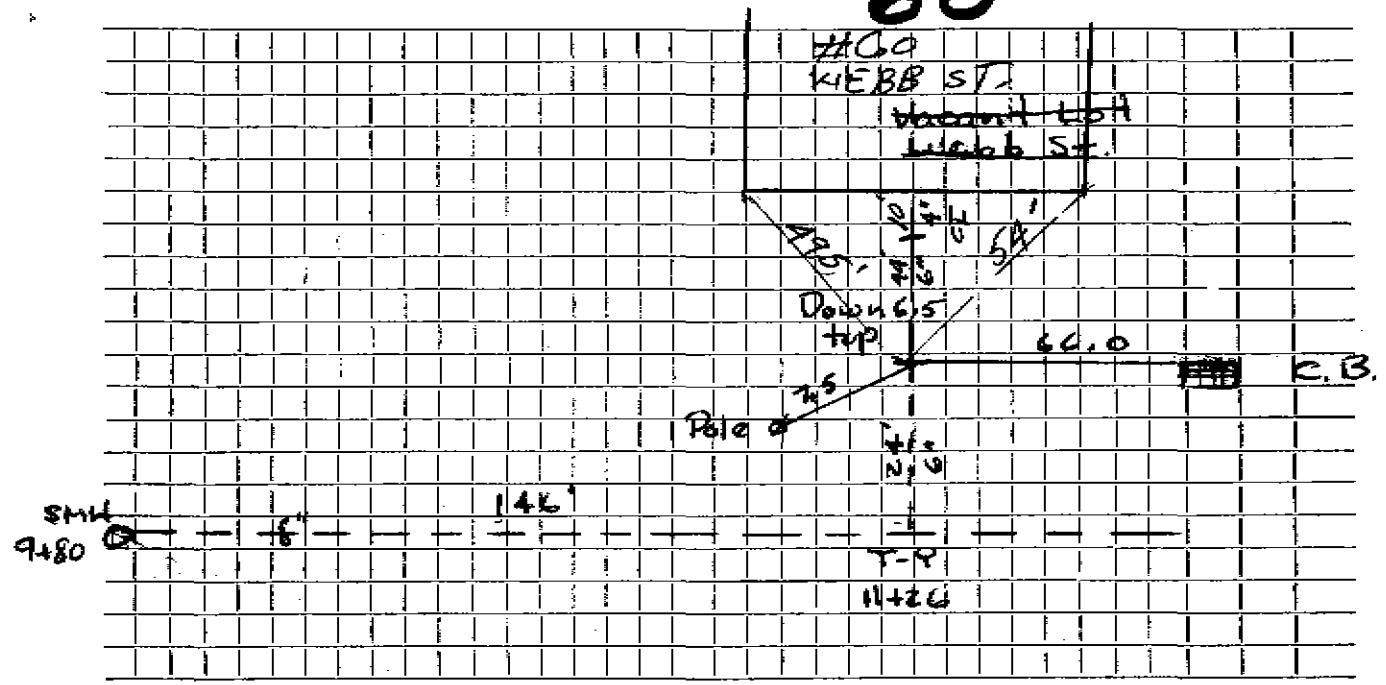

Connection made in Webb St. Street. Work completed .....

Remarks: .....  
.....  
.....