




TOWN OF LEXINGTON — BOARD OF PUBLIC WORKS

SEWER DIVISION

DATE

62

Sketch of Service Here

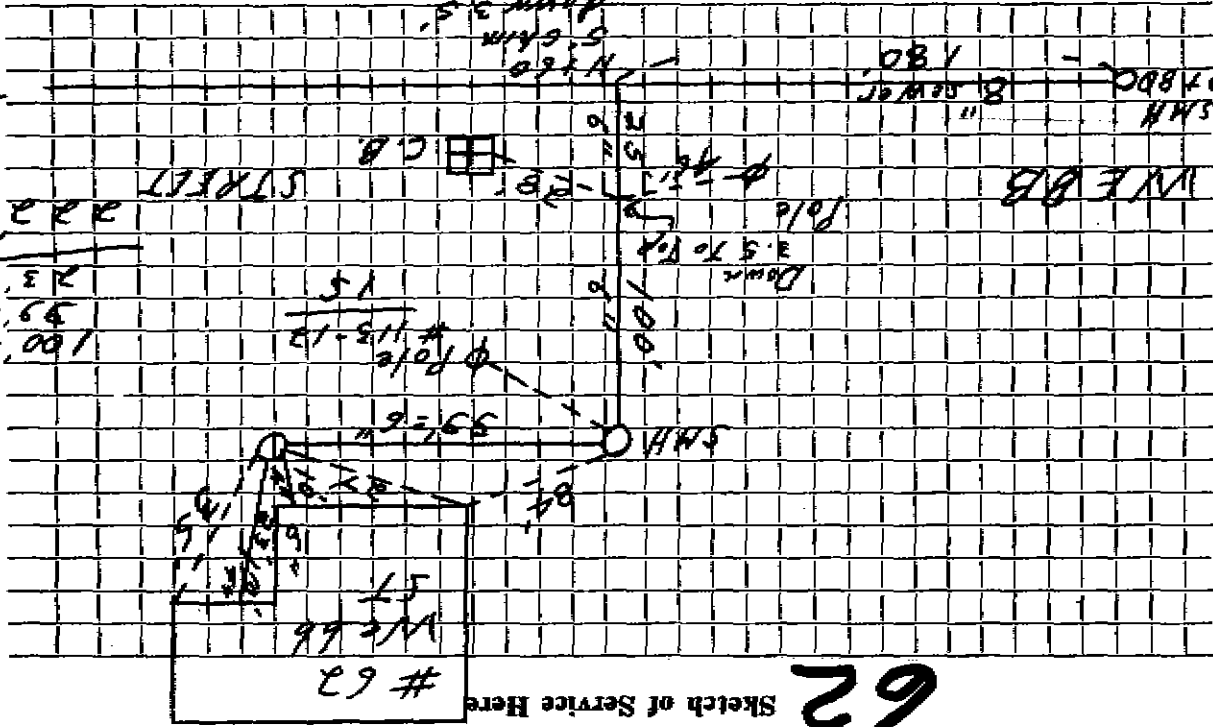

$20' = 4" CI$   
 $10' = 4"$   
 $10' = 4"$   
 $222' = 6" ACP$   


---

 $100' = 6"$   
 $59' = 6"$   
 $23' = 6"$

Work completed

Street

WE 66 Street

Connection made in

Remarks: