


DATE _____

TOWN OF LEXINGTON — BOARD OF PUBLIC WORKS

SEWER DIVISION

Sketch of Service Here

64

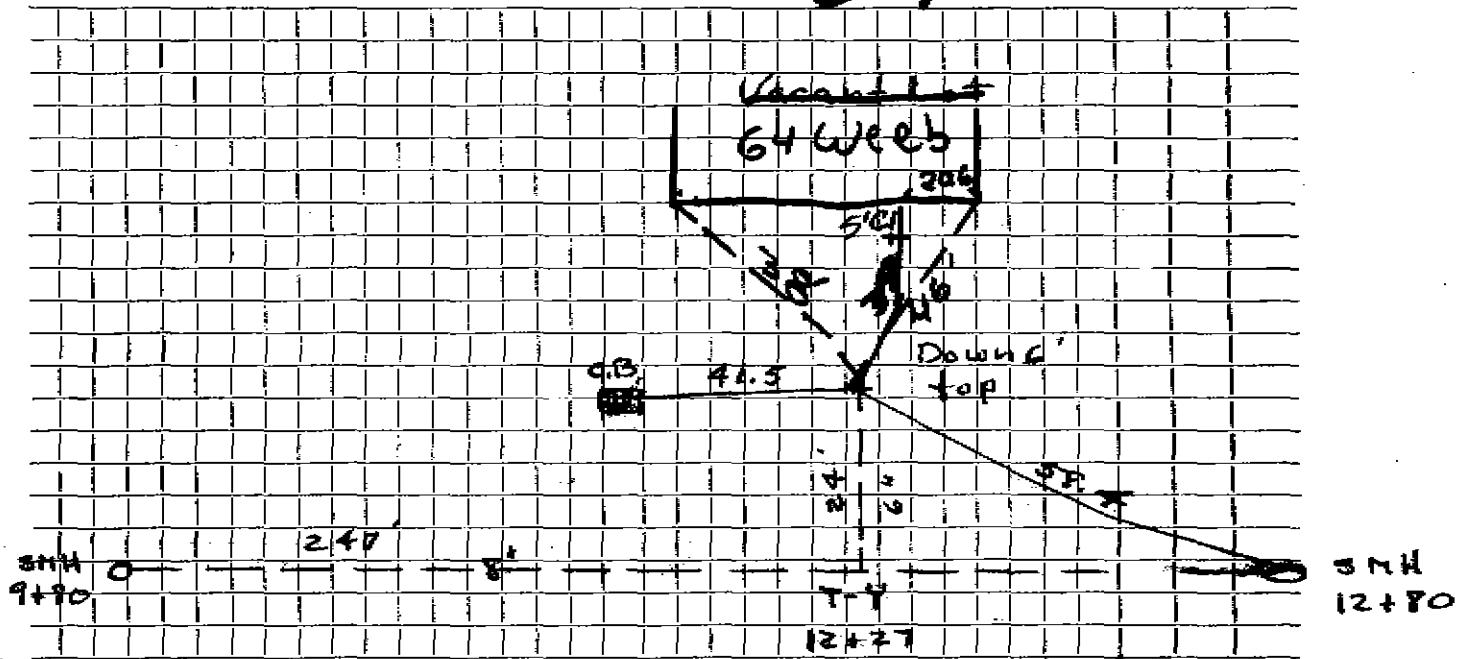

Connection made in 64 Webb St. Street. Work completed 6/29/75

Remarks: _____

