


DATE Dec 1973

TOWN OF LEXINGTON — BOARD OF PUBLIC WORKS
SEWER DIVISION

Sketch of Service Here

68

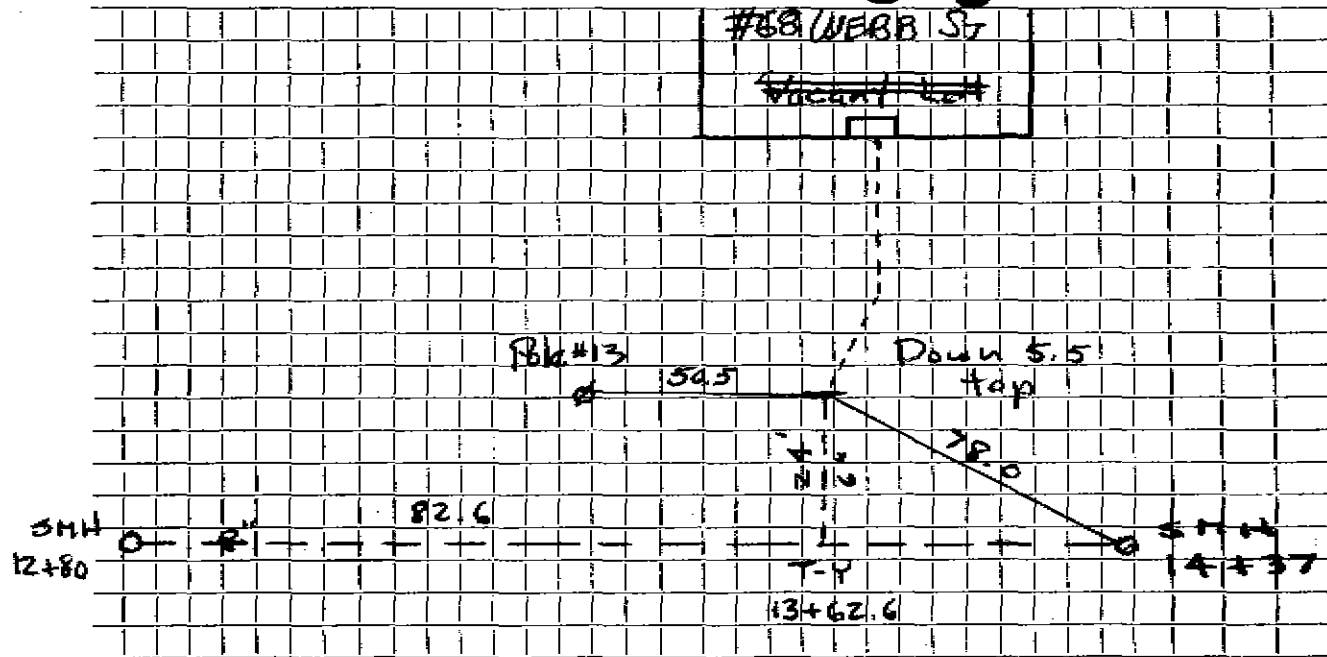

Connection made in webb St. Street. Work completed JAN 14, 1985

Remarks: Water & Sewer Are In Same Trench Approx 4' - 3' Apart.