


DATE MAY 20, 1983

TOWN OF LEXINGTON — BOARD OF PUBLIC WORKS

SEWER DIVISION

Sketch of Service Here

71

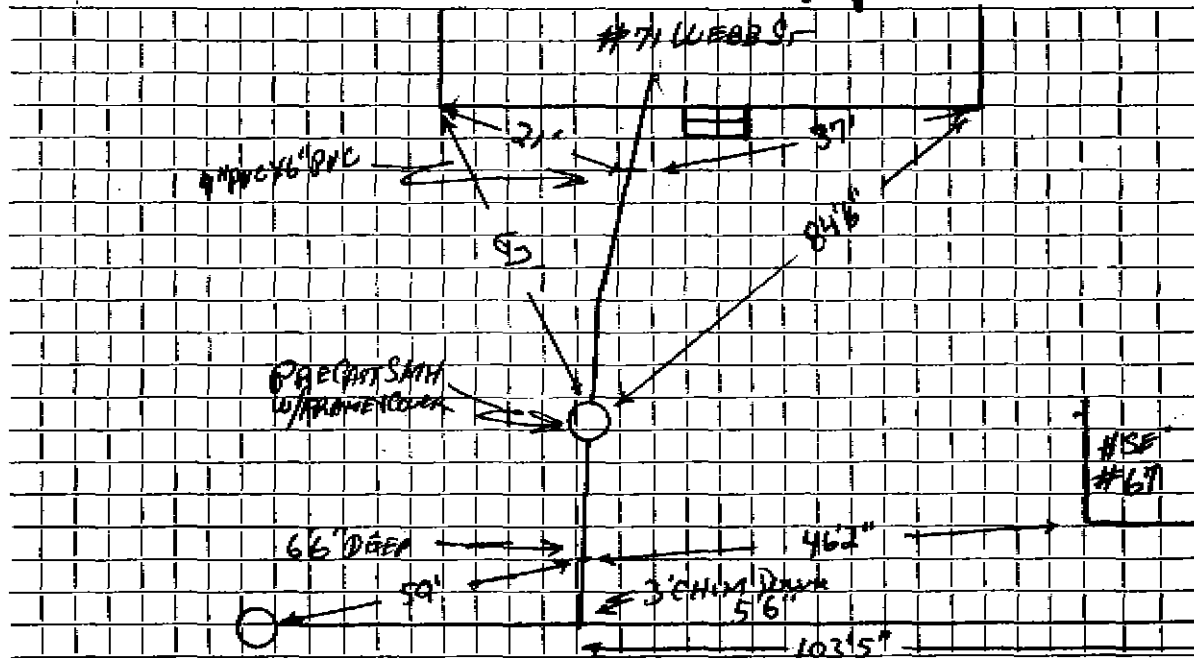

Connection made in WEBB ST Street. Work completed MAY 1983

Remarks:

.....

.....