


DATE _____

TOWN OF LEXINGTON — BOARD OF PUBLIC WORKS

SEWER DIVISION

Sketch of Service Here

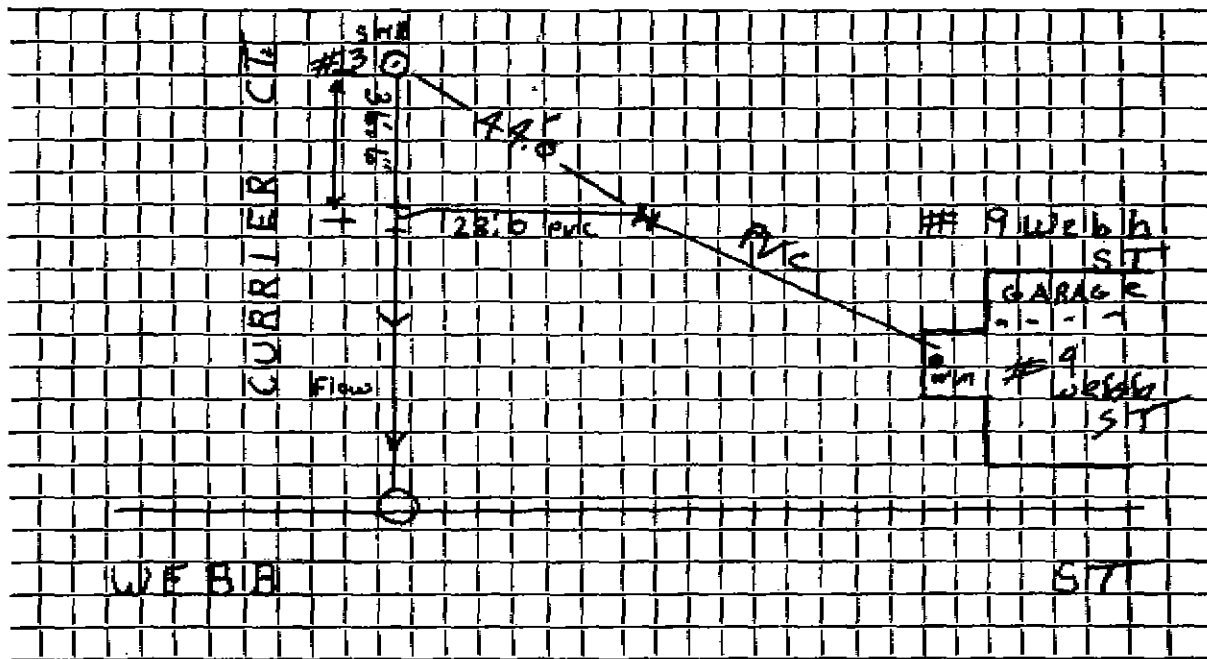

Connection made in Currier Ct. Street. Work completed Sept. 1, 1995 J. McLaughlin


Remarks: old sewer capped at Webb St. J. McLaughlin

DATE _____

TOWN OF LEXINGTON — BOARD OF PUBLIC WORKS

SEWER DIVISION

Sketch of Service Here **9**

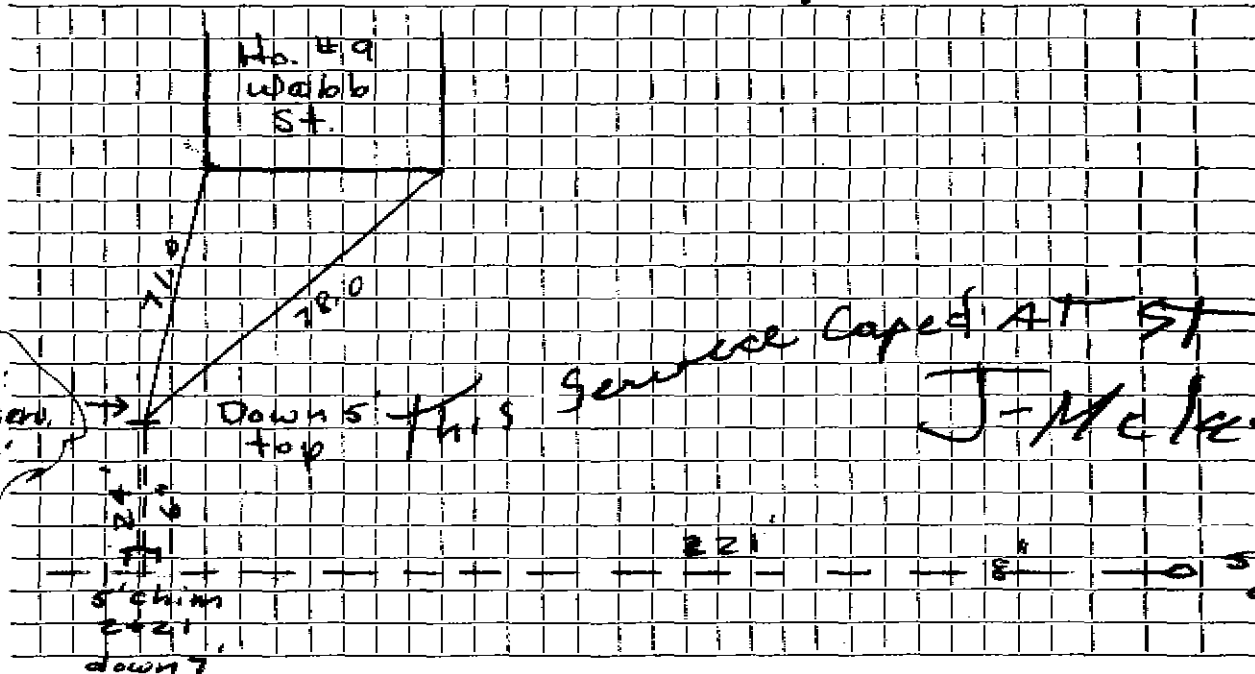

Connection made in Wabab St. Street. Work completed

Remarks: water & Sewer in same trench
New water & sewer ON CURRIER CT.