

Name Paul Iannezzi

Service No. 165

Address # 1 WEBSTER ROAD

Location

Kind of Pipe

Size

Size of Main

~~XXXXXXXXXX~~ New Service

Location Comm 12-10-63


Date	Material	Amount	Total	Date	Amount
10-15-62	Labor	95.11			
	10% O.H.	9.51	104.62	10-11-62	500.00
	125' 6" Transite pipe @82		102.50	12-16-62	222.02
	2 90° Transite Elbows @4.09		8.18		222.98
	2 22½° Transite Bend @4.09		8.18		
	24 X 3 Patch		24.00		
	3 Hrs. Town Shovel @6.50		19.50		
	2 Hrs. Trucking @3.00		6.00		
			272.98		

DATE _____

TOWN OF LEXINGTON — BOARD OF PUBLIC WORKS

SEWER DIVISION

Sketch of Service Here

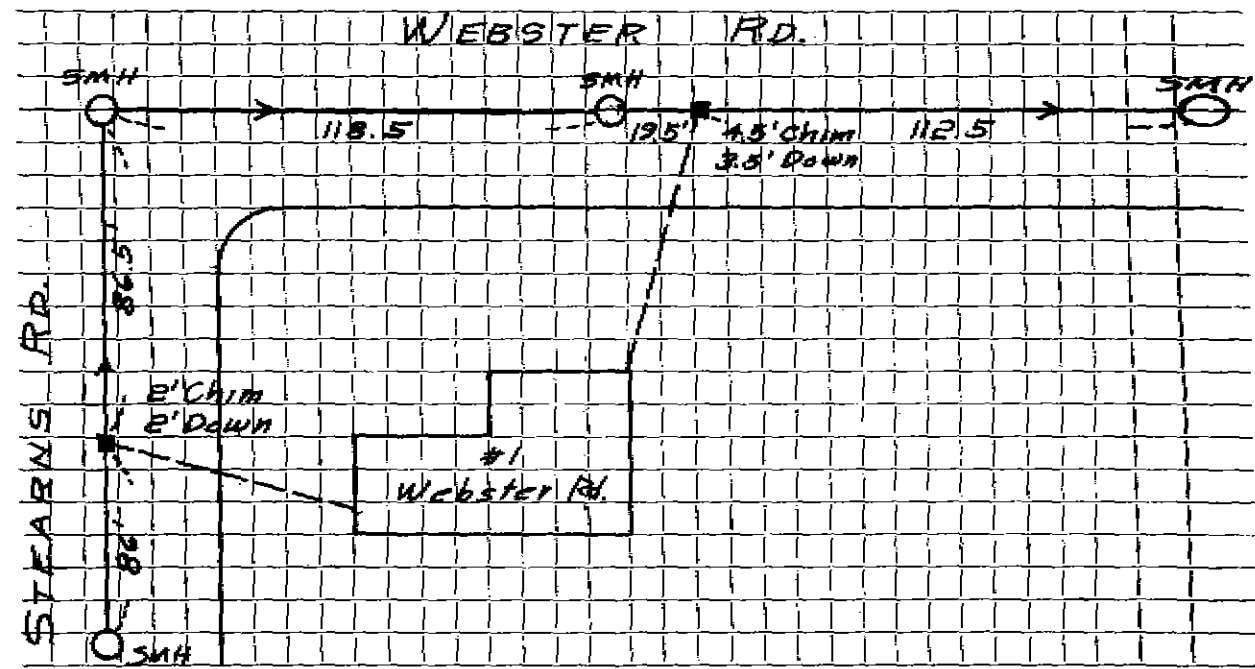

Connection made in _____ Street. Work completed _____

Remarks: _____

