

Name **Leo Rizzo**Service No. **1144**Address **# 10 WEBSTER RD.****UNA-4633**

Location

Kind of Pipe

Size

Size of Main


~~REPLACEMENT~~ **New Service****WO # 7596**Location **Comm 12-10-62**

Date	Material	Amount	Total	Date	Amount
0-10-62	Labor 76.96			9-13-62	250.00
0-11-62	" 88.31			1-8-63	100.12
1-17-62	" 27.56	192.83			350.12
	10% O.H.	19.28	212.11		
	57' 6" Transite pipe @82		46.74		
	6 Ton 3/4" Stone @1.50		9.00		
	1 90° 6" Elbow		4.09		
	1 11 1/2° 6" Bend		4.09		
	7 3/4 ton Bank Gravel @85		6.59		
	5 Hrs. Town Shovel @6.50		32.50		
	6 Hrs. Trucking @3.00		18.00		
	2 Hrs. Pumping @1.00		2.00		
	15 X 3 Patch		15.00		
			350.12		

DATE \_\_\_\_\_

TOWN OF LEXINGTON — BOARD OF PUBLIC WORKS  
SEWER DIVISION

Sketch of Service Here

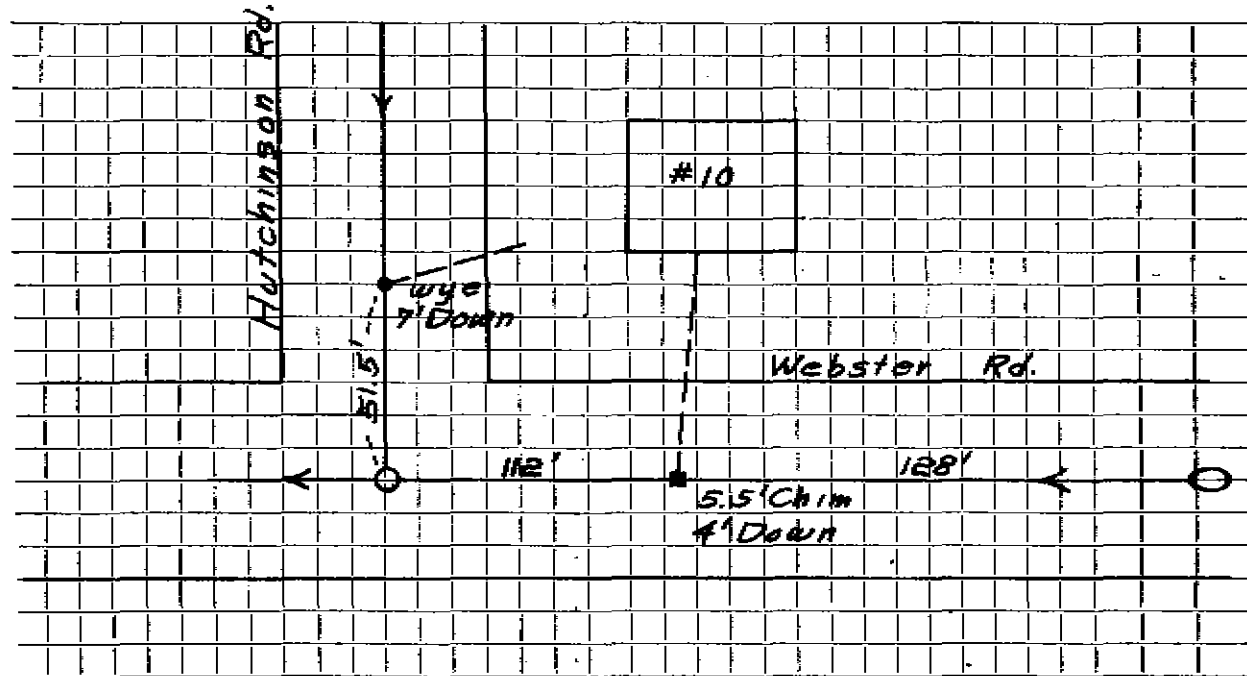

Connection made in ..... Street. Work completed .....

Remarks: .....

.....

.....