

Name Oscar Cornier

Service No. 90

Address # 11 WEBSTER RD.

LOT 74 L.C.

Location

Kind of Pipe

Size

Size of Main

~~XXXXXXXXXXXXXXXXXXXX~~ New Service W.O. # 6763 Farfaras #1451


Location DEC 22 1969

Date	Material	Amount	Total	Date	Amount
8/28/69	Labor	97 30		8-25-69	300 00
9/10/69	"	25 68	122 98	1-30-70	9 08
10	% O.H.		12 30		209 08
20	6" Transite pipe @ .88		17 60		
1	6" Nipple		4 91		
1	90° Elbow		4 09		
1	Adaptor		1 08		
2	Couplings @ 1.09		2 18		
1	6" Plug		1 93		
1	Bag cement 1.55		1 78		
25	Brick @ .05		1 13		
2	Ton cold patch @ 5.50		2 75		
2	Ton hot top @ 5.80		11 60		
15	Hrs. trucking @ 3.00		6 00		
1	" " @ 1.50		2 25		
2	Hrs. shovel @ 6.50		13 00		
1	" compressor		5 00		
1	" roller @ 3.00		1 50		
	trailer		2 00		
			209 08		
-11-69	26' 6" Transite pipe				Bill sent 908
10'	4" Cast Iron pipe				

DATE \_\_\_\_\_

TOWN OF LEXINGTON — BOARD OF PUBLIC WORKS  
SEWER DIVISION

Sketch of Service Here

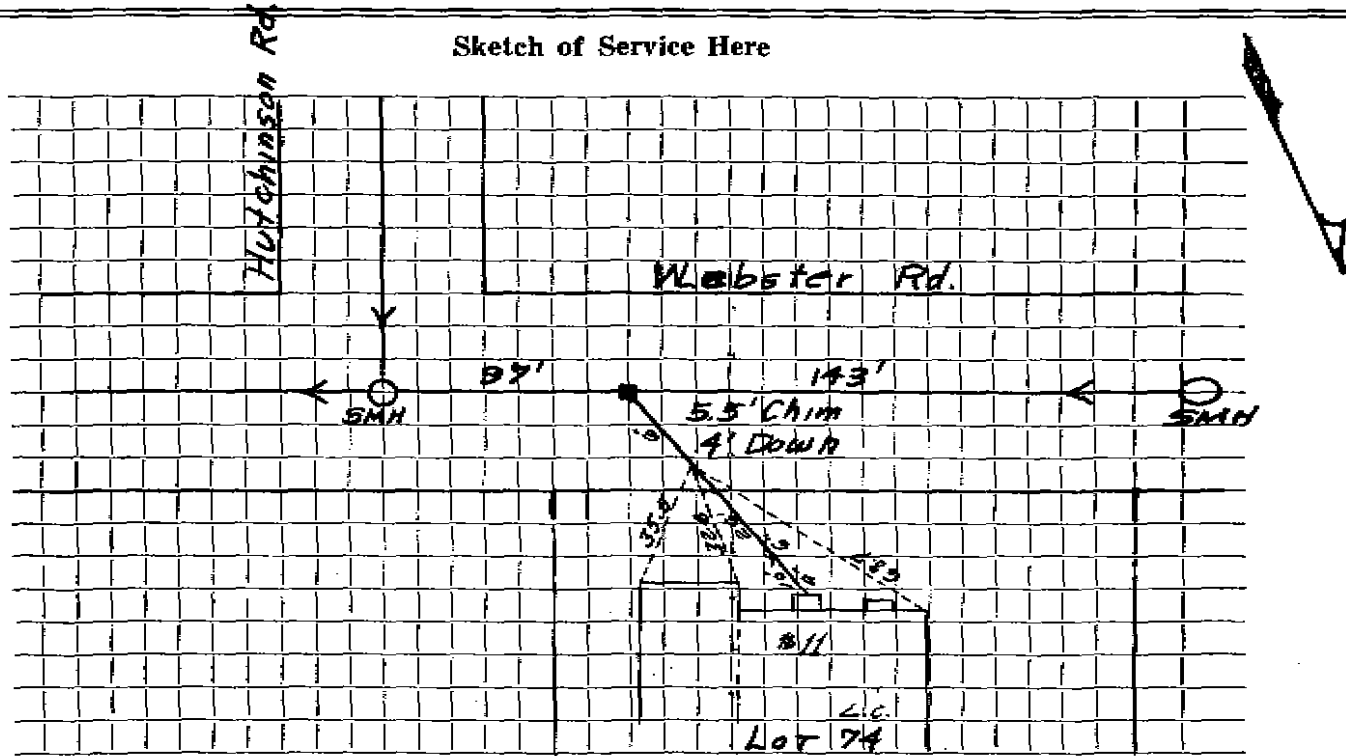

Connection made in ..... Street. Work completed .....

Remarks: .....

.....

.....

.....