

Name Vincent DiSilva

Service No. 49

Address # 16 WEBSTER RD.

Location

Kind of Pipe

Size

Size of Main

~~Repair~~—Renewal—New Service

WO# 7961

Location

Comm 10-28-63


Date	Material	Amount	Total	Date	Amount
5/21/63	Labor	107 04		5-20-63	Deposit 250 00
5/22/63	Labor	20 57		10-28-63	Refund 154
		127 61			248 46
	10% Overhead	12 76	140 37		
	50' 6" Transite Pipe @ .82		41 00		
	7 ton 3/4" Stone @ 1.50		10 50		
	1 90° Transite Elbow		4 09		
	3 hrs. Town Shovel @ 6.50		19 50		
	2 hrs. Trucking @ 3.00		6 00		
	5 yds. Loam @ 3.00		15 00		
	12x3 Patch		12 00		
			248.46		

DATE _____

TOWN OF LEXINGTON — BOARD OF PUBLIC WORKS

SEWER DIVISION

Sketch of Service Here

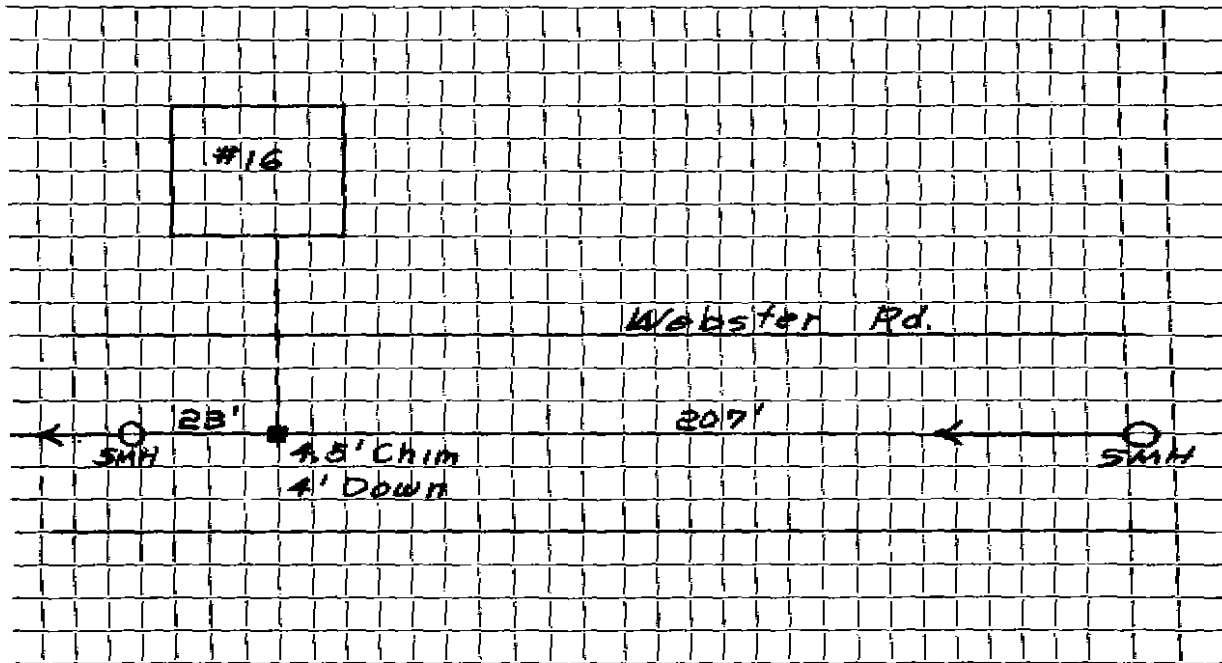

Connection made in Street. Work completed

Remarks:

.....

.....