

Name Mrs. Andrew Belinski

Service No. 61

Address 17 Webster Road

Location

Kind of Pipe

Size

Size of Main

~~Repair~~ ~~Renewal~~ ~~New Service~~

W07#8678

Location

JUN 29 1964


Date	Material	Amount	Total	Date	Amount
5/8/64	Labor	105 57		4-23-64	250 00
	10% O.H.	10 56	116 13	6-29-64	17 97
	53' 6" Transite Pipe @ .82		43 46		232 03
	6 Ton 1 1/2" Stone @ 1.50		9 00		
	1 6" 90° Elbow		4 09		
	1 1 1/4" Transite Elbow		2 35		
	4 Hrs. Town Shovel @ 6.50		26 00		
	2 Hrs. Trucking @ 3.00		6 00		
	1 Hr. Loader @ 4.00		4 00		
	21 X 3 Patch		21 00		
			232 03		

DATE \_\_\_\_\_

TOWN OF LEXINGTON — BOARD OF PUBLIC WORKS

SEWER DIVISION

Sketch of Service Here

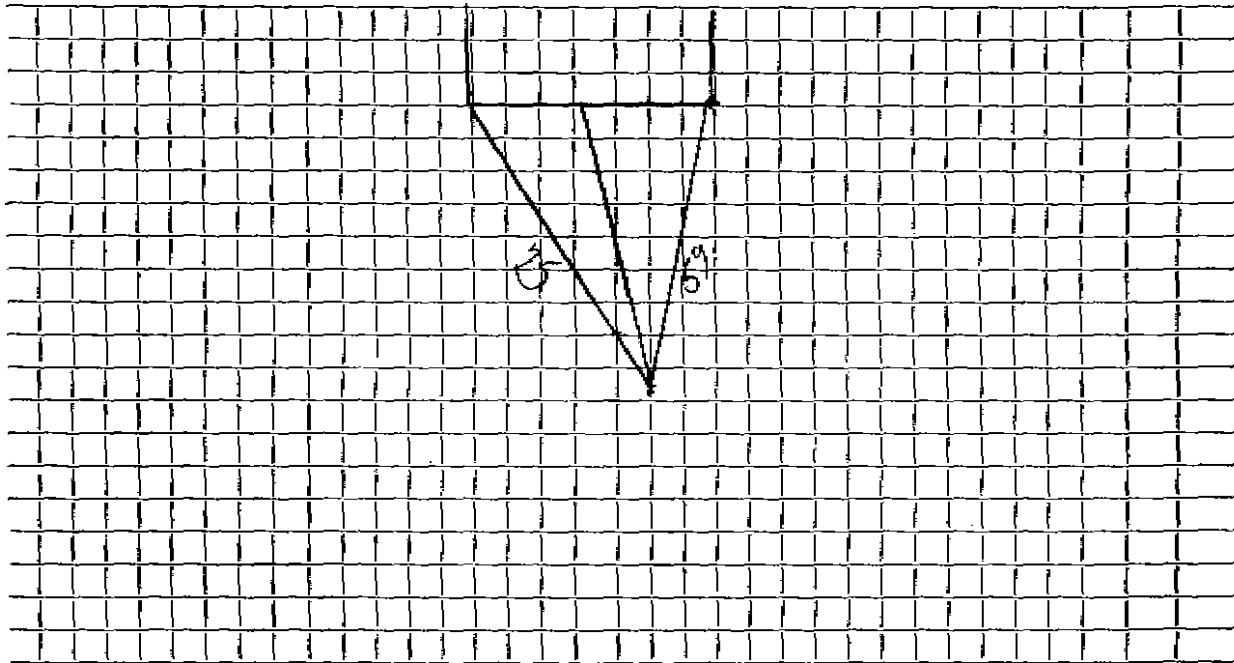

Connection made in ..... Street. Work completed .....

Remarks: .....  
.....  
.....

Name

Service No.

Address #17 WEBSTER RD.

LOT 7E

Location

Kind of Pipe

Size

Size of Main

Repair—Renewal—New Service


Location

Date		Material	Amount		Total		Date		Amount	

DATE \_\_\_\_\_

TOWN OF LEXINGTON — BOARD OF PUBLIC WORKS  
SEWER DIVISION

Sketch of Service Here

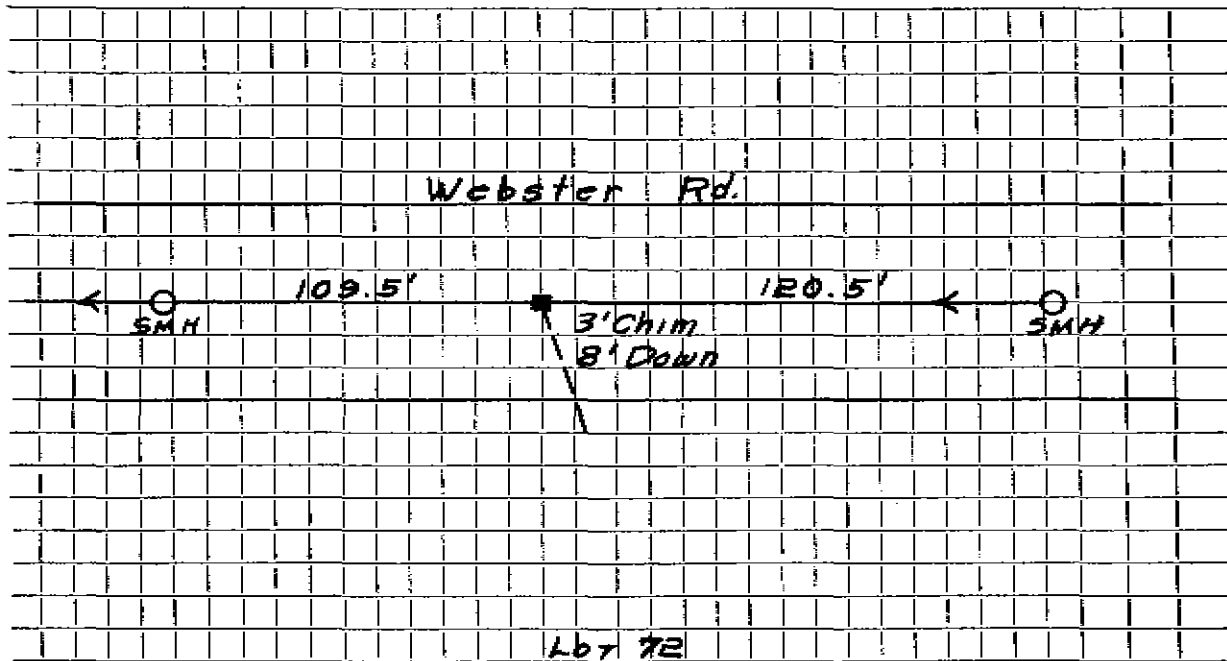

Connection made in ..... Street. Work completed .....

Remarks: .....  
.....  
.....