

Name Joseph Belotti

Service No. 53

Address 19 Webster Road

Location

Kind of Pipe

Size

Size of Main

~~XXXXXXXXXX~~ New Service Russell Sibley Permit #287 W.O. #297

Location MAR 14 1966

Date		Material	Amount	Total	Date	Amount
-65		Labor	94 03		5-12-65	100 00
		10% O.H.	9 40	103 43	4-26-66	36 59
	20'	6" Transite pipe @ .82		16 40	6-17-66	48 00
	1	8 x 6 Saddle		5 25	9-19-66	20 00
	1	90° Elbow		4 09	8-19-66	25 00
	2	Bags cement @ 1.50		3 00	8-23-66	30 00
	25	Brick		1 05	8-6-66	35 00
	1	Load Stone		1 75		296 59
	8	Yds Gravel @ 1,10		8 80		
		17 x 17 Patch		96 32		
	2	Hrs Truck @ 3,00		6 00		
	3	Hrs. Pump @ 1.00		3 00		
	3	Hrs Shovel @ 6,50		19 50		
	2	Hrs Loader @ 4,00		8 00		
25-65	55'	6" Transite pipe		276 59		
						by sum 100.00






DATE \_\_\_\_\_

TOWN OF LEXINGTON — BOARD OF PUBLIC WORKS

SEWER DIVISION

Sketch of Service Here

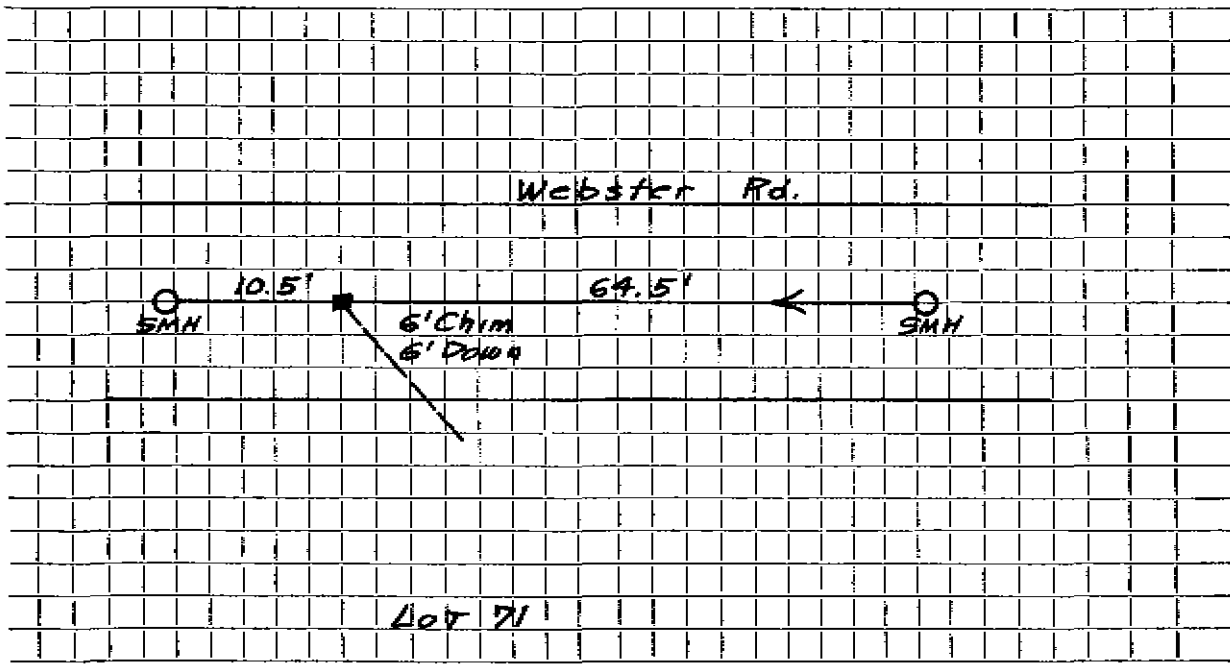

Connection made in ..... Street. Work completed .....

Remarks: .....  
.....  
.....