

Name Joseph Belotti

Service No. 28

Address 21 Webster Road

Location

Kind of Pipe

Size

Size of Main

Repair General — New Service

W.O.# 8598

Location

JUN 29 1964


Date	Material	Amount	Total	Date	Amount
-28-64	Labor	107 99		3-23-64	225 00
	10% O.H.	10 80	118 79	6-29-64	55 05
64'	6" Transite pipe @.82		52 48		219 95
1	90° Transite Elbow		4 09		
1	22½ Transite Bend		4 09		
3	Hrs. Town Shovel @6.50		19 50		
2	Hrs. Trucking @3.00		3 00		
15	X 3 Patch		15 00		
			219 95		

DATE _____

TOWN OF LEXINGTON — BOARD OF PUBLIC WORKS

SEWER DIVISION

Sketch of Service Here

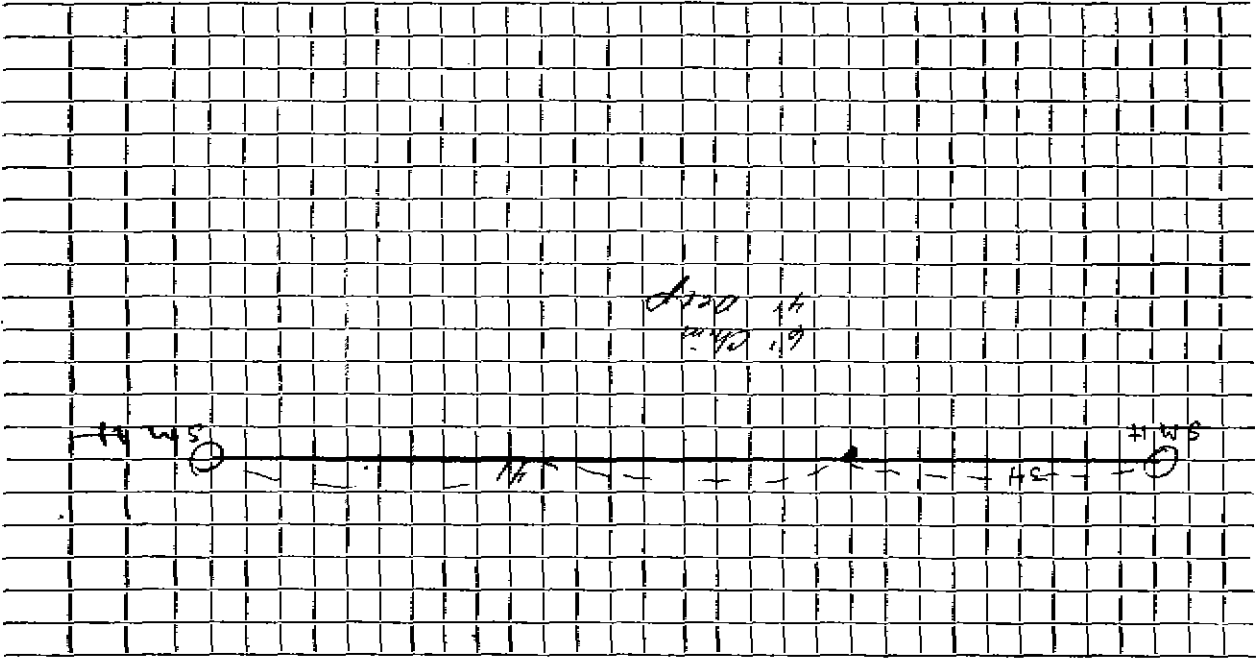

Work completed

Street

Connection made in

Remarks:

Name

Service No.

Address # 21 WEBSTER RD.

LOT 70

Location

Kind of Pipe

Size

Size of Main

Repair—Renewal—New Service

Location

Date

Material

Amount

Total

Date


Amount

DATE _____

TOWN OF LEXINGTON — BOARD OF PUBLIC WORKS

SEWER DIVISION

Sketch of Service Here

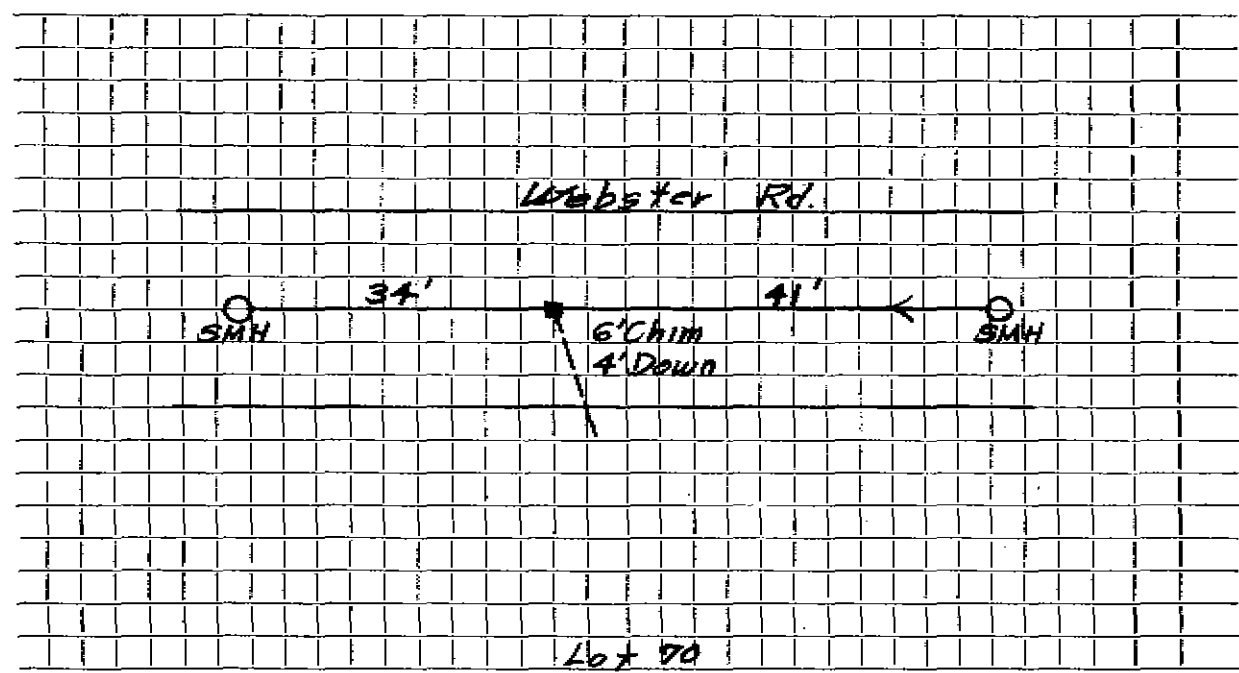

Connection made in Street. Work completed

Remarks:
.....
.....