

Name **William Marchese**

Service No. **159**

Address **#22 WEBSTER RD.**

Location

Kind of Pipe

Size

Size of Main

~~Revised~~ **New Service**

**W OFF 26.52**

Location **Comm 12-10-62**


Date	Material	Amount	Total	Date	Amount
10-22-62	Labor	65.79		10-4-62	Deposit 300.00
	10% O.H.	6.58	72.37	12-10-62	Refund 100.53
55'	6" Transite pipe @82		45.10		199.47
4	Hrs. Town Shovel @650		26.00		
2	Hrs. Trucking @3.00		6.00		
50X3	Patch		50.00		
			199.47		

DATE \_\_\_\_\_

# TOWN OF LEXINGTON — BOARD OF PUBLIC WORKS

## SEWER DIVISION

Sketch of Service Here

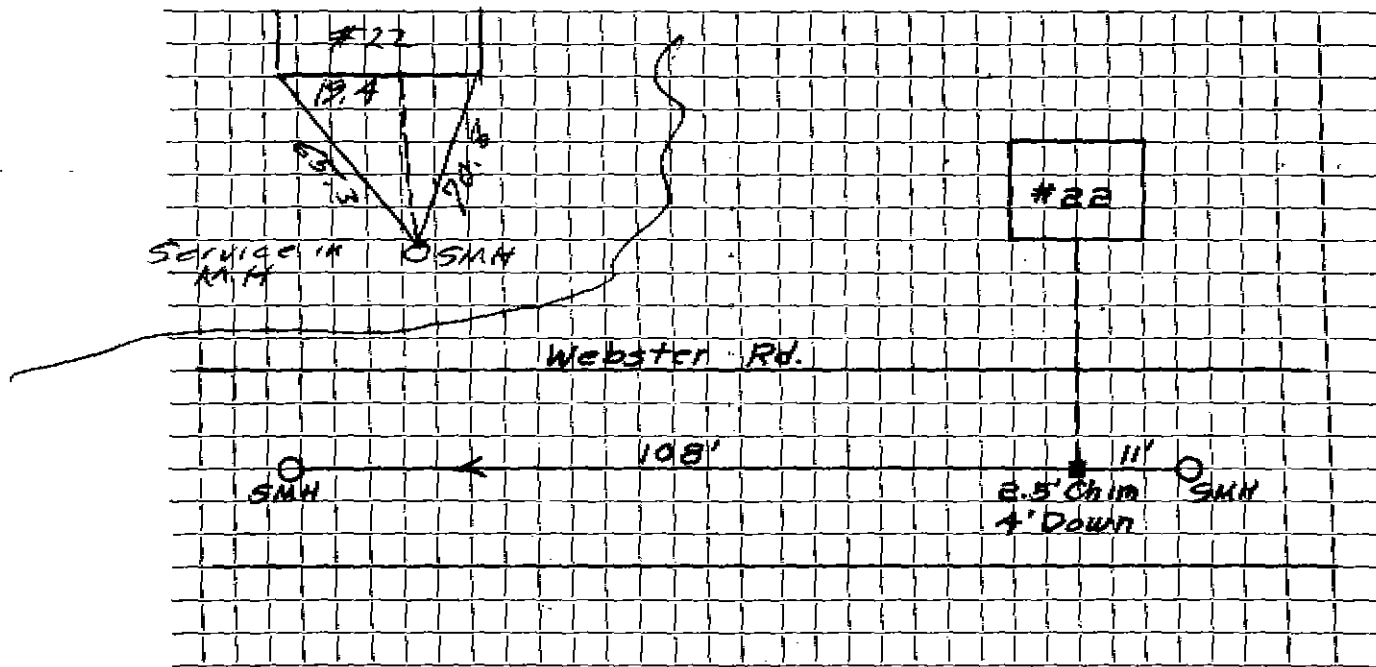

Connection made in ..... Street. Work completed .....

Remarks: .....  
.....  
.....