

Name **Thomas F. Culkean**

Service No. **164**

Address **# 23 WEBSTER RD.**

Location

Kind of Pipe

Size

Size of Main

~~Repair~~ ~~Renewal~~ **New Service**

W o n 7662

Location

Comm 12-10-62


Date	Material	Amount	Total	Date	Amount
10-16-62	Labor	88.31		10-11-62	200.00
10-17-62	"	31.02	119.33	1-10-63	63.32
	10% O.H.	11.93	131.26		263.32
54'	6" Transite pipe @82		44.28		
22	3/4" Ton Bank Gravel @85		19.34		
8	Ton 1" Stone @1.50		12.00		
1	22 1/2" Transite Elbow		2.35		
1	11 1/4" Transite Bend		4.09		
12 X 3	Patch		12.00		
4	Hrs. Town Shovel @6.50		26.00		
4	Hrs. Trucking @3.00		12.00		
			263.32		

DATE _____

TOWN OF LEXINGTON — BOARD OF PUBLIC WORKS

SEWER DIVISION

Sketch of Service Here

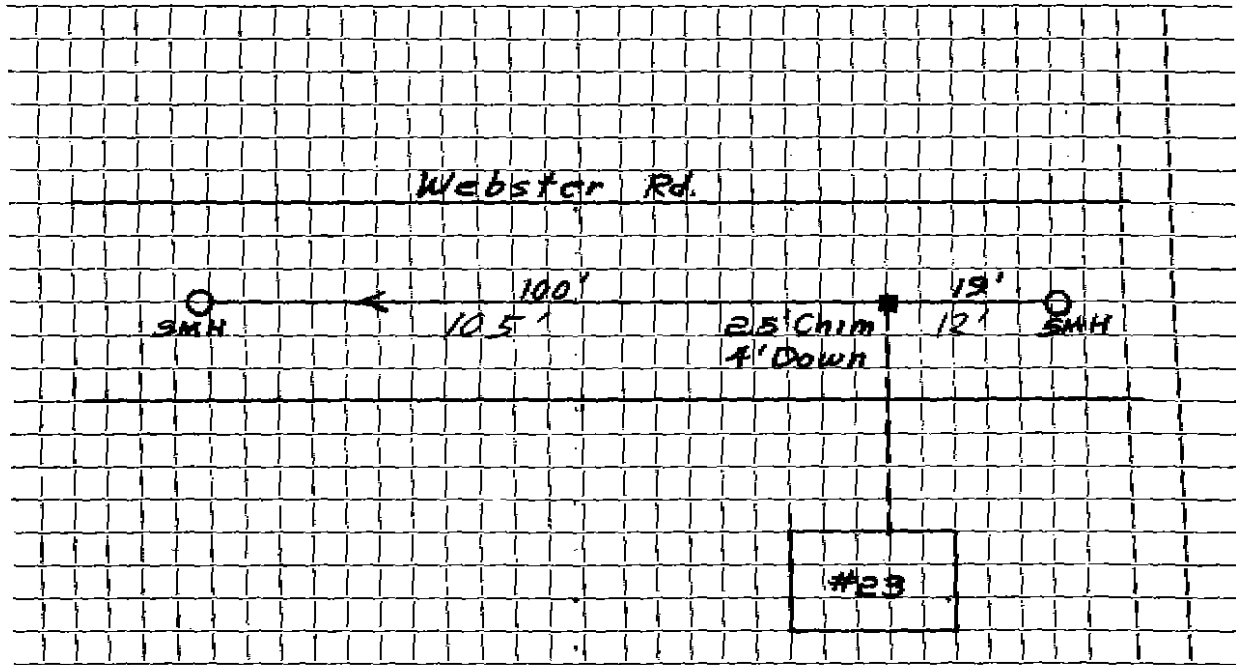

Connection made in Street. Work completed

Remarks:

.....

.....