

Name Robert Jackson

Service No. 166

Address #24 WEBSTER RD.

Location

Kind of Pipe

Size

Size of Main

~~XXXXXX~~ New Service

W.C. # 7676

Location Com on 1-14-63


Date	Material	Amount	Total	Date	Amount
11-6-62	Labor	72.88		10-19-62	300.00
11-7-62	"	72.88		4-24-65	59.26
11-8-62	"	20.68	166.44		359.26
	10% O.H.	16.64	183.08		
95'	6" Transite pipe @.82		77.90		
3½	ton 1" Stone @1.50		5.25		
1	22½° Transite Bend		4.09		
1	22½° Transite Elbow		2.35		
1	90° Transite Elbow		4.09		
15	x 3 Patch		15.00		
5	hrs. Town Shovel @6.50		32.50		
5	hrs. Trucking @3.00		15.00		
	Spring Loam & Seed		20.00		
			359.26		

B. [unclear] 59.26

DATE _____

TOWN OF LEXINGTON — BOARD OF PUBLIC WORKS
SEWER DIVISION

Sketch of Service Here

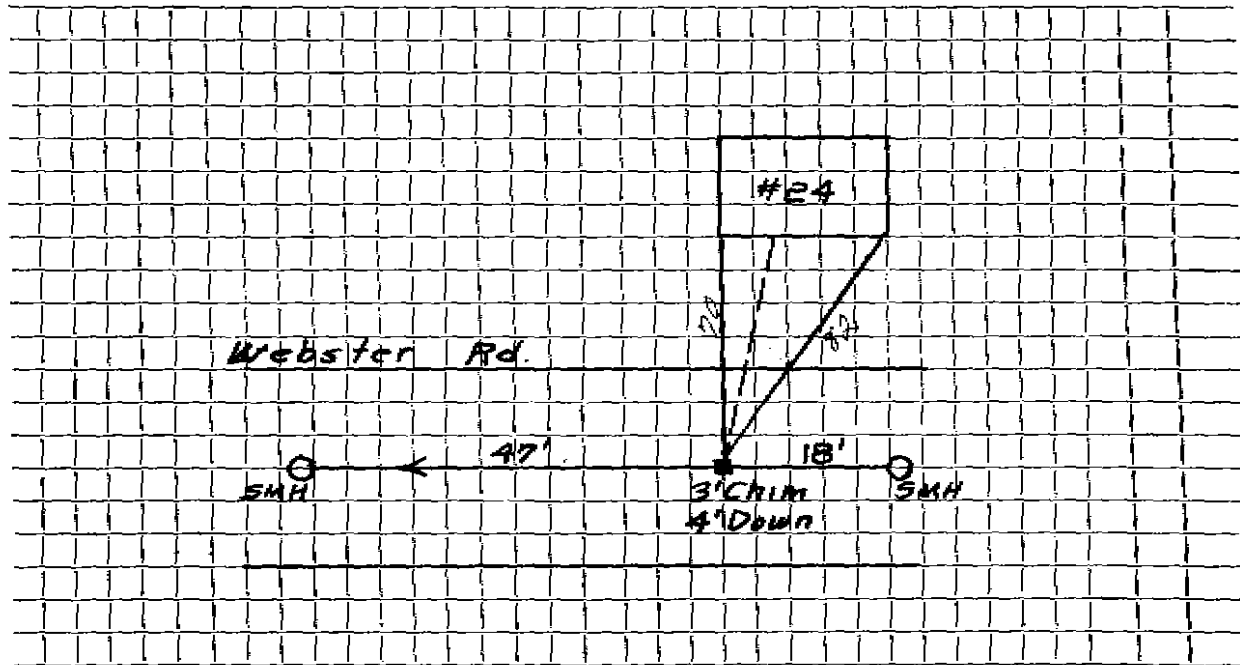

Connection made in Street: Work completed

Remarks:

.....

.....