

Name William Marlowe

Service No. 78

Address #25 WEBSTER RD.

Location

Kind of Pipe

Size

Size of Main

Repair—Renewal—New Service Lucente#695 W.O.#5028

Location


MAR 18 1968

Date		Material	Amount	Total	Date	Amount
-15-67	36'	6" Transite pipe			7-6-67	150 00
	10'	4" Cast Iron pipe			4-29-68	150 00
7/6/67		Labor	85.62			
8/28/67		Labor	14.42			
7/28/67		Labor	12.39	112 43		
		10% O.H.	11 26	123 67		
	15'	sewer pipe @ .88		13 20		
	1	ton hot top @		5 80		
	3	hrs. shovel @ 6.50		19 50		
	5	hrs. trucking @ 3.00		15 00		
	1/2	hr. loader @ 4.00		2 00		
	1/2	hr. roller @ 3.00		1 50		
				180 67		
						Bill sent 30.67

DATE _____

TOWN OF LEXINGTON — BOARD OF PUBLIC WORKS
SEWER DIVISION

Sketch of Service Here

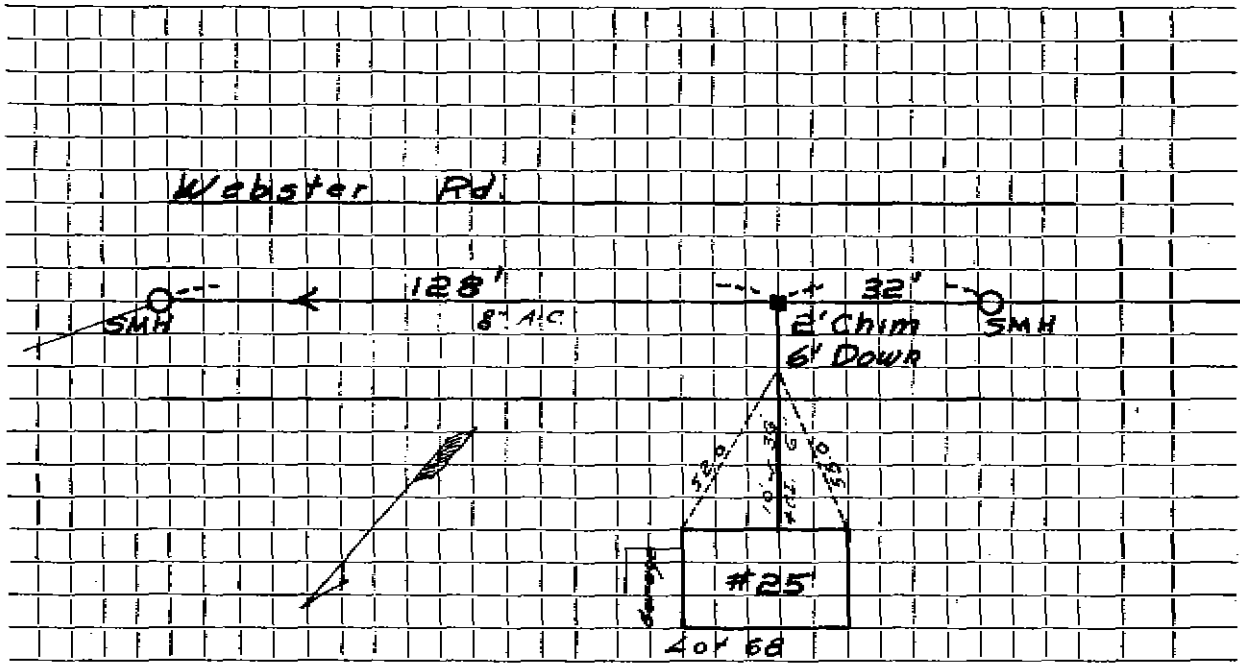

Connection made in Street. Work completed

Remarks:
.....
.....